

© 2009 FKP Architects, Inc. All rights reserved. No part of this document may be reproduced or utilized in any form without prior written authorization of FKP Architects, Inc.

Indicates Roller Shade size & location.

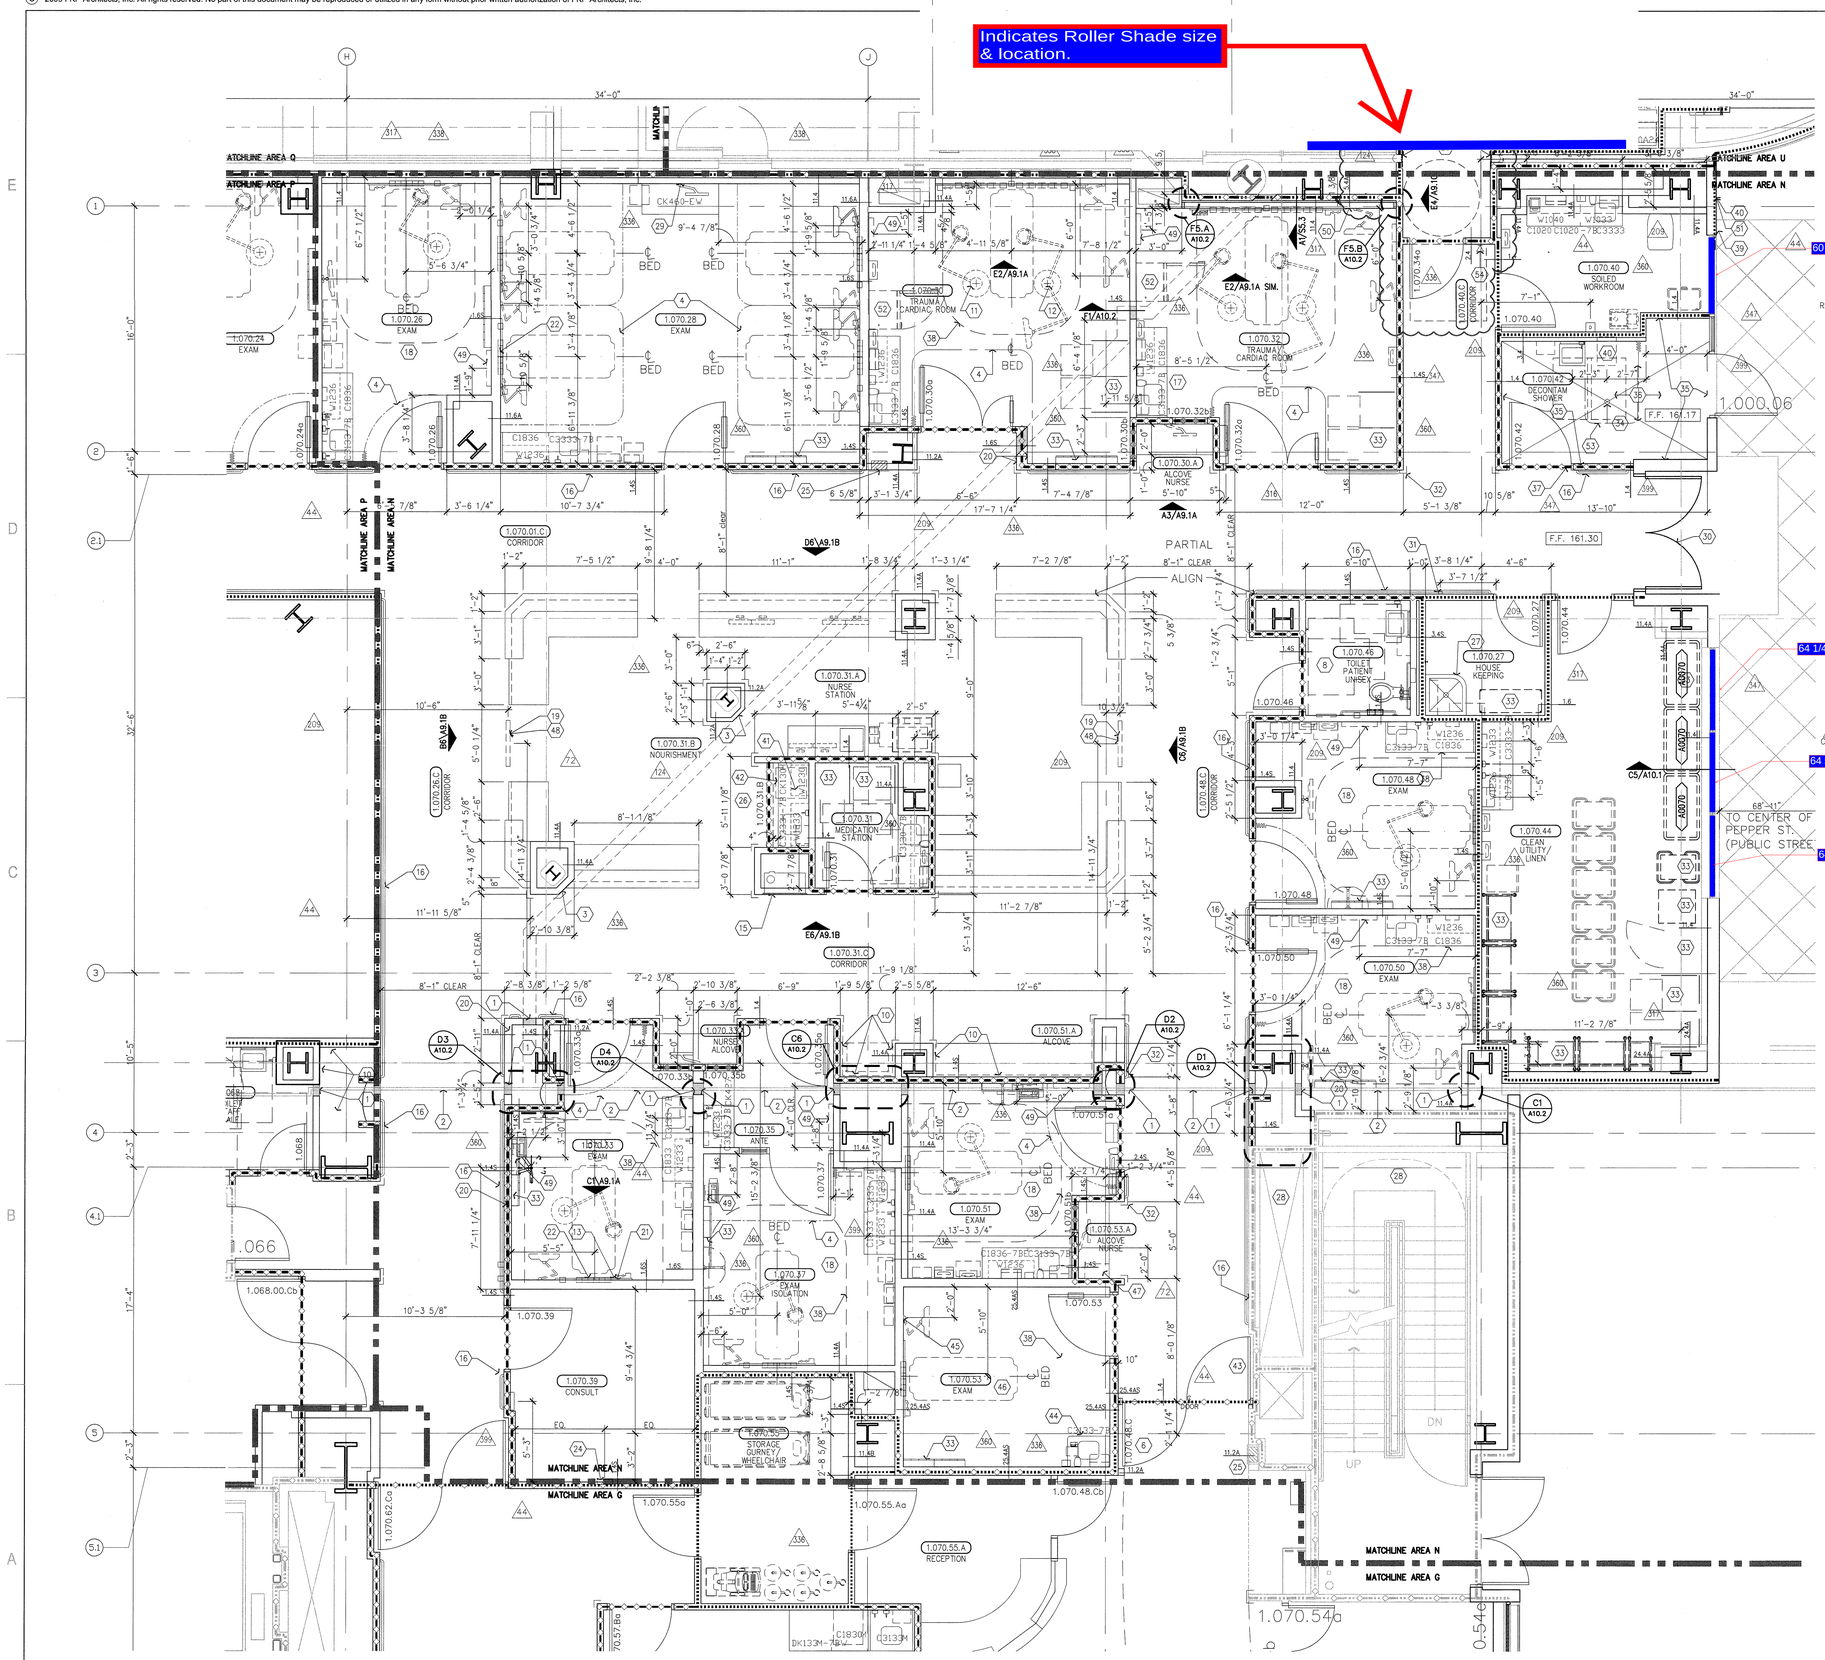

A6 AREA N
1/4" = 1' - 0"

A1 KEY PLAN

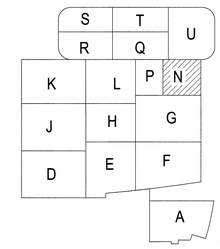

D1 NOTES TO SHEET

A. Information shown or referenced on enlarged and/or 1/4" scale drawings will generally not be shown on the smaller scale drawings.
B. Partition types are scheduled on plans by number. See the "General Notes to B2/A11.3 and Partition Types on Sheet A11.3, A11.3.1, and A11.3.2 for definition of partition type references.
C. Field coordinate all field routed pipe, conduit runs, etc., with locations of recessed accessories and equipment. In the event of a conflict, accessory locations take precedence.
D. Close all joints between plumbing fixtures/accessories and dissimilar materials w/sealant (i.e. between sinks and countertops, toilet fixtures and accessories to wall, etc.)
E. Cabinet numbers noted on enlarged plans refer to Cabinet component numbers, fixtures, accessories, etc. that are defined or elevated on Sheet A9.0 unless specific detail references are keyed.
F. Plan dimensions – refer to B2/A11.3 (General Notes).
G. For vertical mounting heights of shower accessories, See Detail D6/A11.7.
H. For vertical mounting heights of typical toilet stall accessories, See Detail A4/A11.7.
I. For vertical mounting heights of accessible toilet stall accessories, See Detail A5/A11.7.
J. For vertical mounting heights of typical restroom accessories, See Detail B6/A11.7.
K. For vertical mounting heights of accessible accessories at restrooms, See Detail A6/A11.7.
L. For equipment not identified on plan, see Equipment drawings and workbook–Increment#7, Vol. 2E.
M. For partial enlarged plan at janitor closets, See Detail A3/A11.7.
N. Public/handicapped restroom graphics will be furnished and installed by the Owner's graphics supplier.
O. Standard equipment wall mounting heights, see detail A2/A11.9.
P. Medical equipment wall mounting heights, see details A4/A11.9, D3/A11.9 & QQ.02–Increment #7, Vol. 2E.
Q. Fire Protection equipment wall mounting heights, see detail D2/A11.9
R. Communication equipment wall mounting heights, see detail A3/A11.9.
S. Equipment mounting heights at Countertops, see detail D3/A11.9.
T. Equipment mounting heights at Desktops, see detail A4/A11.9.
U. A minimum head clearance of 6'-8" must be maintained at all points in stairways including stair and landing framing.
V. For all dashed in equipment not identified, refer to EQ drawing series–Increment #7, Vol. 2E and Equipment workbook. Specific items requiring structural support are cross referenced to structural support details via matrix shown on the Equipment drawings–Increment #7, Vol. 2E.
W. All elevator hoist way entrance frames to have an embossed stainless steel graphic plaque with the floor landing number and Standard Braille markings for the blind. Conform to governing Accessibility codes and standards.
X. All stair floor landings to receive stencil painted, semi-gloss enamel floor landing numerals 12" high adjacent to the door at 5'-0" AFF in a contrasting color to the scheduled wall color unless a graphic plaque is specifically detailed or noted.
Y. Elevator Equipment Wall Mounting Heights, see detail A6/A11.9 and B3/A11.9.
Z. Doors, Frames, Sidelites and Windows: (See Door Schedule). See A11 sheet series.
AA. Provide wall blocking/backing for items weighting 20lbs or less. See A6/A11.3.1.
BB. For personal effects storage unit types and sizes see A4/A11.8.
CC. For typical equipment backing support, see A4/S1.1–Increment #5.
DD. For boundaries of alternates and phasing, see the AP drawing series.
EE. Provide 3" grommet, unless otherwise noted at 3'-0" O.C. maximum, field located at all electrical components at Nurses stations and Reception desks.
FF. For vertical mounting heights of service accessories, See Detail A3/A11.
GG. Provide access panels below the Patient Room countertops to serve as inspection ports for the Patient Room bathtubs.

B1 GENERAL NOTES

1. Expansion joint cover,wall. See plan for fire rating requirements.
2. Seismic expansion joint cover, floor. See increment #6 floor plan.
3. Align face of partition with edge of slab above..
4. Cubicle curtain track, ceiling mounted. See D4/A11.8.
5. Not used.
6. Integrated double egress door, wall recessed. See D5 & D6/A11.4
7. TV monitor, wall mounted.
8. Accessible toilet room. See typical plan detail B3/A11.7.
9. Not used.
10. Sheet wall protection to 48" A.F.F. See IA drawings.
11. Articulated boom with exam light, ceiling mounted. See reflected ceiling plan and Equipment drawings and workbook. Typical
12. Articulated boom with exam light, monitor, PACS image, ceiling mounted. See reflected ceiling plan and Equipment drawings and workbook. Typical
13. Nurse call, wall mounted. See Telecom drawings.
14. Not used
15. Pneumatic tube station. OFOI. See Electrical.
16. Handrail/bumperrail. See detail B4/A11.8
17. See room 1.070.30 for typical note designations, elevations.
18. See room 1.070.33 for typical note designations, elevations.
19. Tracking board, ceiling mounted. See reflected ceiling plan, see D1/S3.5.
20. Physiological monitor, wall mounted. See Equipment drawings and workbook.
22. Medical gas outlets, stub drops ceiling. See Plumbing.
23. Approved Wall / Ceiling expansion joint system
24. Medical gas outlets. See Plumbing.
25. Fire extinguisher cabinet, wall recessed, paint to match adjacent wall, typical. See detail B2/A11.8.
26. Fire shutter, automatic roldown, ceiling recessed.
27. Housekeeping mop sink. See detail B2/A11.7.1.
28. For construction requirements, this area, see Increment 6, Vol. 2A & 2B.
29. Wall mounted Monitor for backing detail see A6/A11.3.1.
30. Automatic doors to remain.
31. Push button for automatic doors.
32. Corner guards, high impact plastic surface mounted, See detail B4/A11.8. Typical
33. Equipment item. See EQ drawing series for description. Typical.
34. Floor drain. See Plumbing.
35. Add layer of cementitious wallboard below inner layer of mold and moisture resistant board, all walls.
36. Remove topping slab, Feather floor prep to be flush with door, Slope to drain.
37. Door has flat threshold. See hardware schedule.
38. OSHPD clearance zone around bed (F.1.0)
39. 18" X 18" access panel for mixing valve. 5'–0" top of access panel to finish floor.
40. ESEW locations see plumbing drawings for type.
41. Provide self–closing spring loaded hinged cabinet doors.
42. Refrigerator, under counter.
43. Integrated double egress door, wall recessed. See C4/A11.4.2
44. Modified C33 base cabinet to have (2) layers of substrate on all surfaces for added security. Front panel to be secured with locking hardware. Faucet to be mounted to sink and substrate. Refer to detail B6/A11.8.2
45. Install backing, power and data for monitor – no bracket/rail.
46. Do not install privacy curtains.
47. Sharps container.
48. Provide structural mount above ceiling (see Det. B4/S5). Bottom of mount to be ceiling height + 6" above F.F.
49. Charting station per RTKL ME equipment drawings. See A6/A11.3.1 for backing detail.
50. For top of wall support details see A1/S5.3 Inc. #7.
51. Relocated existing water valve see D2/A5.12 Inc. #5.
52. Wall mounted towel warmer at 38" bottom, for backing see D2/S3.3 detail and equipment plan for model specification.
53. Signage, verify type.
54. Approved handsfree intercom with door system. Mounted 48" A.F.F.

FKP Architects

ARCHITECT OF RECORD
Paul C. Gloriod

REGISTERED ARCHITECT PAUL C. GLORIOD No. C 20381 STATE OF CALIFORNIA

Changes on these drawings do not consist of materially altered changes to approved drawings and don't require a change order.
OSHPD review ADO _____
OSHPD review FLSO _____
OSHPD review DSE _____

REVISIONS

44	05/28/10	ASI #08
72	11/18/10	CO # 63
124	01/12/11	ASI#45
209	03/10/11	ASI#74
59	06/23/11	CO #226
317	08/22/11	CO#247
338	08/24/11	ASI #111
338	10/10/11	CO#263
347	10/24/11	ASI#115
399	12/19/11	ASI#141
431	01/30/12	CO#325
360	03/12/12	CO#281
444	04/03/12	CO#329

APPROVAL

Office of Statewide Health Planning & Development/FDD REVIEWED IN ACCORDANCE WITH THE REQUIREMENTS OF T24, CCR
ADDENDUM

PPD# 2012-04327
5/1/12
CHANGE ORDER# 329
INSTRUCTION BULLETIN#_____
DEFERRED APPROVAL#_____
ADDENDUM_____

PROJECT NAME
CHILDREN'S HOSPITAL OF ORANGE COUNTY
455 S. Main St.
Orange, CA 92868-3874

TOWER II

CHOC SM HOSPITAL

PROJECT NUMBER
12011.00
Increment #7

OSHPD - PROJECT NUMBER
IL 072072-30

ISSUE
OSHPD PERMIT

DATE
01/27/2010

SCALE
1/4" = 1' - 0"


DRAWING TITLE
LEVEL 1 ENLARGED PLAN AREA - N

DRAWING NUMBER
A3.1N

N:\06XXX\06102 CHOC TOWER 2 SHELL BUILDING\FKP CONTRACTED PROJECTS\PROJECT INCREMENTS\INCR. #07 - TENANT IMPROVEMENT\OSHPD PERMIT (CONSTRUCTION DOCUMENTS)\106102_CO#_____\A3.1N.DWG
4/12/2012
RONALD

© 2009 FKP Architects, Inc. All rights reserved. No part of this document may be reproduced or utilized in any form without prior written authorization of FKP Architects, Inc.

Indicates Roller Shade size & location

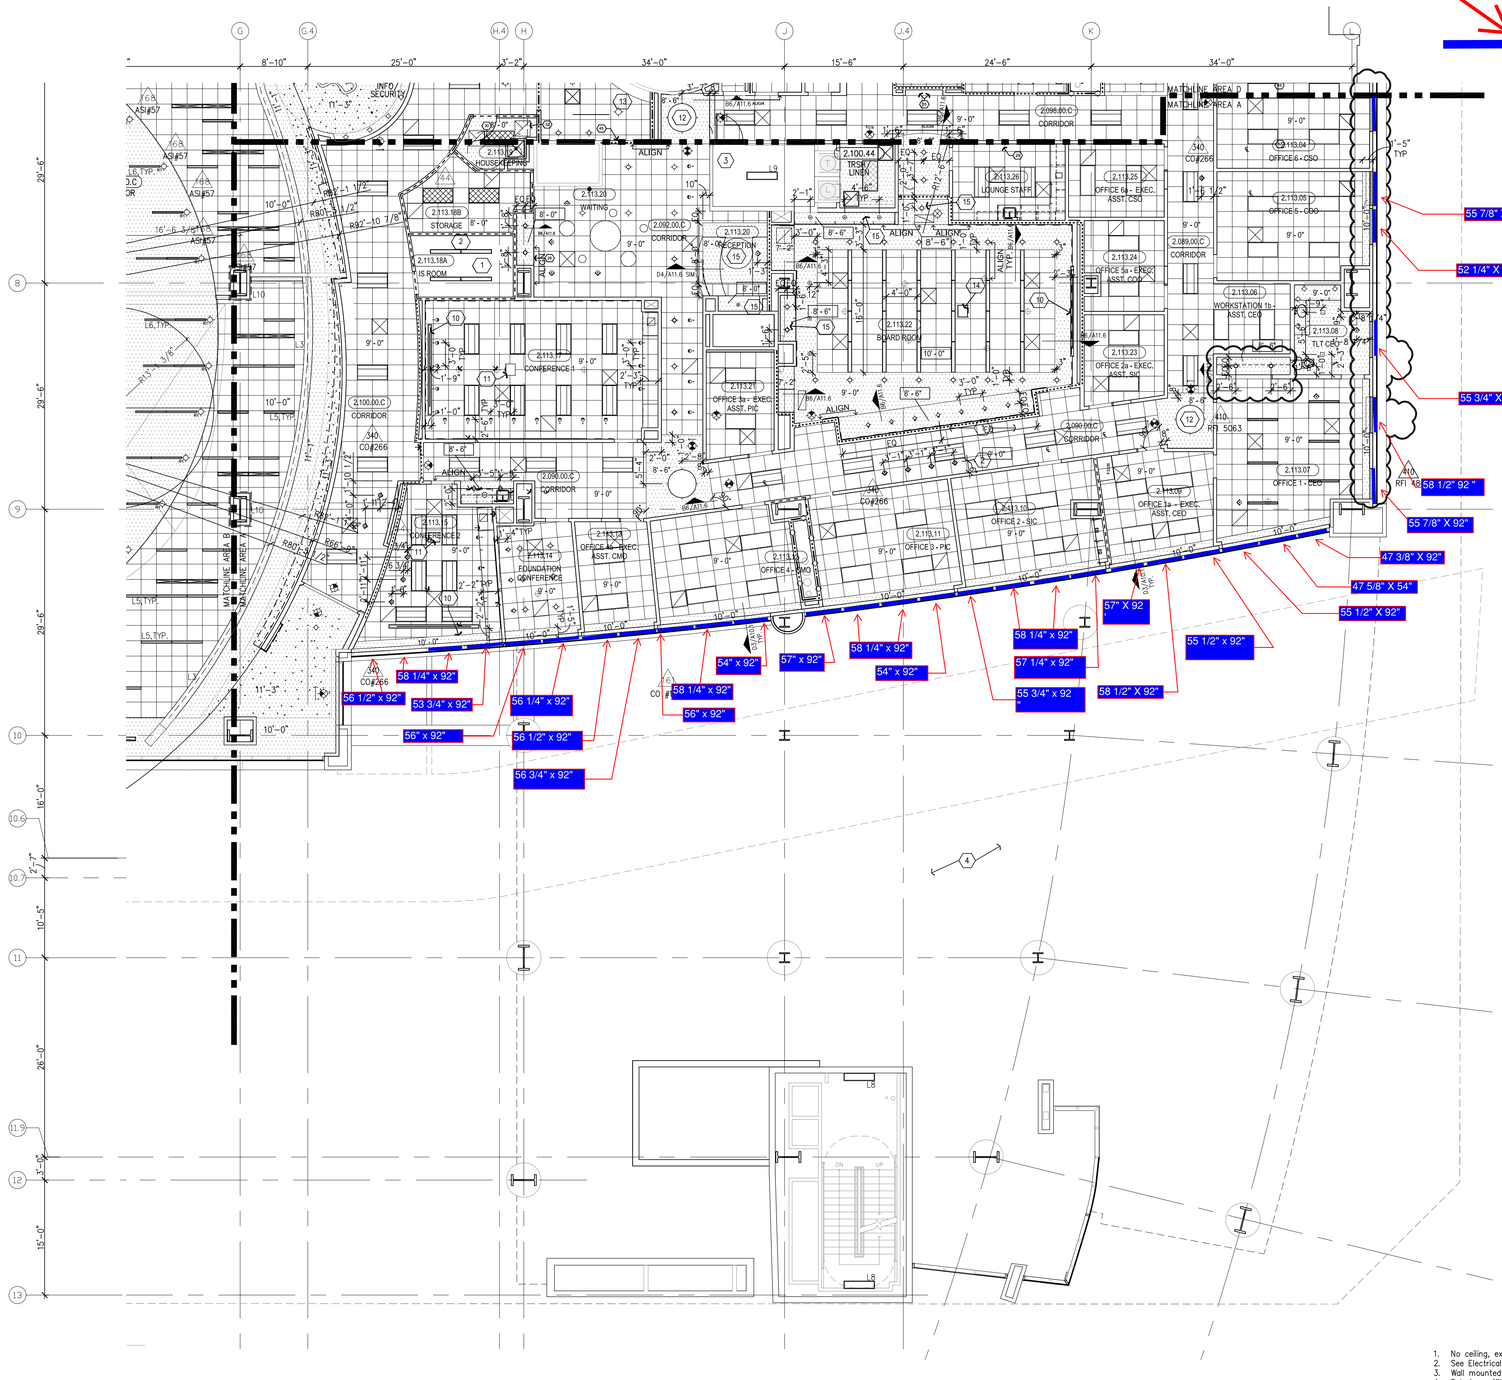

A6 AREA A
1/8" = 1'-0"

- LASER – IN USE LIGHT
- EXIT LIGHT FIXTURE
- RECESSED COMPACT FLUORESCENT DOWN LIGHT
- RECESSED COMPACT FLUORESCENT DIRECTIONAL SPOT LIGHT
- RECESSED LED DOWN LIGHT, WALL WASH TRIM, JUNO (W)
- WALL MOUNTED LIGHT FIXTURE
- RECESSED COMPACT FLUORESCENT DOWN LIGHT WITH DIMMER (D)
- RECESSED EXAM LIGHT, W/ WALL MOUNTED CONTROLS
- LOUIE LIGHTING, SD–888 RECESSED LIGHT
- RECESSED FIXTURE, P–8900, PRUDENTIAL LIGHTING (R2)
- LOUIS POULSEN, COLLAGE PENDANT (P1)
- PENDANT FIXTURE, QUEENY DOWN II, BRUCK (P2)
- BOYD, 9955 ARCHETYPE PENDANT, DIMMING SATIN NICKEL (P3)
- BOYD, 10217 CATACAOS PENDANT (30"), DIMMING SATIN NICKEL (P4)
- CORELITE, VERTECH 2T8 4' SUSPENDED DIRECT/INDIRECT LINEAR FIXTURE (P5)
- BOA CALO SWING SPOT, BRUCK, WITH V/A TRACK, BRUCK
- BRUCK LEDRA DISPLAY TRACK AND SPOT LIGHT
- COLOR KINETICS, ICOLOR FLEX SL, TRACK MOUNTING
- COLOR KINETICS, ICOLOR FLEX SL, STRING LIGHT
- INDIRECT COVE FIXTURE, P–59, PRUDENTIAL LIGHTING (L1)
- PERIMETER WALL WASHER W/ ACRYLIC LENS ,FOCUS 1,FOCAL POINT (L2)
- LED COVE LIGHT (L3)
- FLUORESCENT COVE LIGHT (L4)
- FLUORESCENT WITH FLUSH LENS, AVENUE b, FOCAL POINT (L5)
- EUREKA C49169 LIGHT FIXTURE (L6)
- CEILING MOUNTED NURSE CALL INDICATOR
- 4" X 2' FLUORESCENT WALL MOUNTED LIGHT FIXTURE (L7)
- RECESSED FLUORESCENT LIGHT FIXTURE
- 1' X 4' FLUORESCENT WALL MOUNTED LIGHT FIXTURE (L8)
- 1' X 4' FLUORESCENT UTILITY LIGHT FIXTURE SURFACE MOUNTED LED LIGHT (L9)
- 2' X 4' FLUORESCENT LIGHT FIXTURE WITH PARABOLIC LENS (L10)
- 2' X 4' FLUORESCENT LIGHT FIXTURE DIRECT/INDIRECT
- 2' X 4' FLUORESCENT LIGHT FIXTURE WITH PRISMATIC LENS
- MULTI FUNCTION PATIENT LIGHT FIXTURE
- SQUARE MECHANICAL GRILLES
- LINEAR MECHANICAL GRILLES
- PLASTER CEILING
- METAL PANEL SOFFIT
- GYPSUM BOARD CEILING
- OVERHEAD CABLE TRAY– SEE T5.13A FOR DETAIL
- 2' X 2' SUSPENDED ACOUSTICAL TILE
- FLUORESCENT STRIP FIXTURE
- 7" X 8' "GAMMALUX" WALL MOUNTED LIGHT FIXTURE (WF1)
- BUTTERFLY SPOT, BRUCK, WITH ENZIS TRACK
- MANUAL ROLLER SHADE WITH POCKET (STD. HEADBOX)
- MANUAL ROLLER SHADE WITH FASCIA/ VALENCE (410 RFI 486.4)

C1 Legend
N.T.S.


A. REFER TO "FINISH SCHEDULE" FOR FURTHER DEFINITION OF CEILING MATERIALS AND FINISHES.
B. CEILING HEIGHT WILL TYPICALLY BE [9'–0"], UNLESS OTHERWISE NOTED ON THE REFLECTED CEILING PLAN.
C. LOCATE ALL CEILING MOUNTED SMOKE DETECTORS AND SPEAKERS IN THE CENTER OF FULL PANELS AT LAY–IN CEILINGS.
D. LOCATE ALL SPRINKLER HEADS IN THE CENTER OF FULL PANELS AT LAY–IN CEILINGS. AT GYPSUM BOARD CEILINGS, SYMMETRICALLY SPACE HEADS AND CENTER ON LIGHT ROWS WHERE AREA LIMITATIONS PERMIT.
E. REFER TO MEP DOCUMENTS FOR LOCATIONS OF CEILING ACCESS PANELS. UNLESS NOTED OR DETAILED OTHERWISE ACCESS PANELS IN TOILETS AND BACK OF HOUSE SPACES WITH DRYWALL OR PLASTER CEILINGS ARE TO BE PAINTED METAL. PLASTER OR DRYWALL CEILINGS WITH ACCESS PANELS IN AUTOPSY AND BODY HOLDING AREAS ARE TO BE STAINLESS STEEL.
F. FOR SEISMIC BRACING AND ANCHORAGE REQUIREMENTS FOR SUSPENDED ACOUSTICAL CEILINGS, SEE SHEET A11.10.
G. FOR SEISMIC BRACING AND ANCHORAGE REQUIREMENTS FOR SUSPENDED GYPSUM BOARD CEILINGS SEE SHEET A11.10.1.
H. GYPSUM BOARD FURRDOWN HEADERS WILL NOT BE LOWER THAN 8' A.F.F.
I. ALL CEILING MOUNTED ITEMS WITH EQUIPMENT TAGS IDENTIFIED ON EQUIPMENT SERIES SHEETS ARE CROSSED REFERENCE TO STRUCTURAL SUPPORT DETAILS VIA MATRIX SHOWN ON EQUIPMENT DRAWINGS.
J. FOR ALL LAY IN CEILING PANELS ARRANGE CEILINGS TO NOT HAVE LESS THAN ½" CEILING TILE UNLESS OTHERWISE NOTED.
K. PROVIDE 2" WIDE TRIM AT ALL PERIMETER OF ACOUSTICAL CEILING GRID SYSTEM TO MEET SEISMIC REQUIREMENTS.
L. IN THE EVENT OF A CONFLICT BETWEEN REFLECTED CEILING PLANS AND FINISH SCHEDULES, THE REQUIREMENTS OF TABLE 1224.1 CBC 2007 PART 2 SHALL GOVERN.
M. FOR O.R. DIFFUSER ARRAY, PROVIDE 2x4 SUSPENSION SYS. W/ GASKETS (GORDON INC. : GC–15); HOLD DOWN CLIPS; ALUMINUM PANELS (USG: PANZ 2x4 (SMOOTH) SQUARE EDGE LAY–IN.

B1 General Notes
N.T.S.

1. No ceiling, exposed to structure.
2. See Electrical and Mechanical for lighting and HVAC in this space.
3. Wall mounted diffusers, see Mechanical drawings.
4. Exterior soffit, see Increment 6, Vol. 2A.
5. Not used.
6. Not used.
7. Not used.
8. Not used.
9. Not used.
10. Projection screen, recessed ceiling. Locate centerline of screen with centerline of projector. See Detail D3/A11.6 and Telecom.
11. Ceiling mounted projector. See Telecom.
12. Locate center of light fixture with centerline of both corridors.
13. Match existing grid to provide continuous like new system.
14. Ceiling mounted projector, recessed. Locate centerline of projection screen with centerline of projector. See telecom.
15. Locate center of light fixture with centerline of soffit.

(6) CO #134

A2 Notes To Sheet
N.T.S.

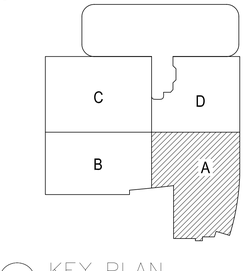

A1 KEY PLAN

FKP Architects

ARCHITECT OF RECORD
Paul C. Gloriod

LICENSED ARCHITECT MICHAEL L. SMITH NO. C 20081 REN. 1-31-13 STATE OF CALIFORNIA

Changes on these drawings do not consist of materially altered changes to approved drawings and don't require a change order.
OSHPD review ACO _____
OSHPD review FLSO _____
OSHPD review DSE _____

REVISIONS

44	05/28/10	ASI #08
68	02/04/11	ASI #57
161	03/01/11	CO#134
340	09/05/11	CO#266
410	01/09/12	ASI #156

APPROVAL

Office of Statewide Health Planning & Development/FDD REVIEWED IN ACCORDANCE WITH THE REQUIREMENTS OF T24, CCR APPROVED

CHANGE ORDER#_____
INSTRUCTION BULLETIN#_____
DEFERRED APPROVAL#_____
ADDENDUM_____

PROJECT NAME
CHILDREN'S HOSPITAL OF ORANGE COUNTY
455 S. Main St.
Orange, CA 92868-3874

TOWER II

CHOC SM HOSPITAL

PROJECT NUMBER
12011.00
Increment #7

OSHPD - PROJECT NUMBER
IL 072072-30

ISSUE
OSHPD PERMIT

DATE
01/27/2010


SCALE
1/8" = 1' - 0"

DRAWING TITLE
LEVEL 2
REFLECTED
CEILING PLAN
AREA - A

DRAWING NUMBER
A4.2A

N:\6XXX\08102 CHOC TOWER 2 SHELL BUILDING\FKP CONTRACTED PROJECTS\PROJECT INCREMENTS\INCR. #07_TENANT IMPROVEMENT\OSHPD PERMIT (CONSTRUCTION DOCUMENTS)\108602_C01_____\A4.2A.DWG
1/24/2012
RONALD

© 2009 FKP Architects, Inc. All rights reserved. No part of this document may be reproduced or utilized in any form without prior written authorization of FKP Architects, Inc.

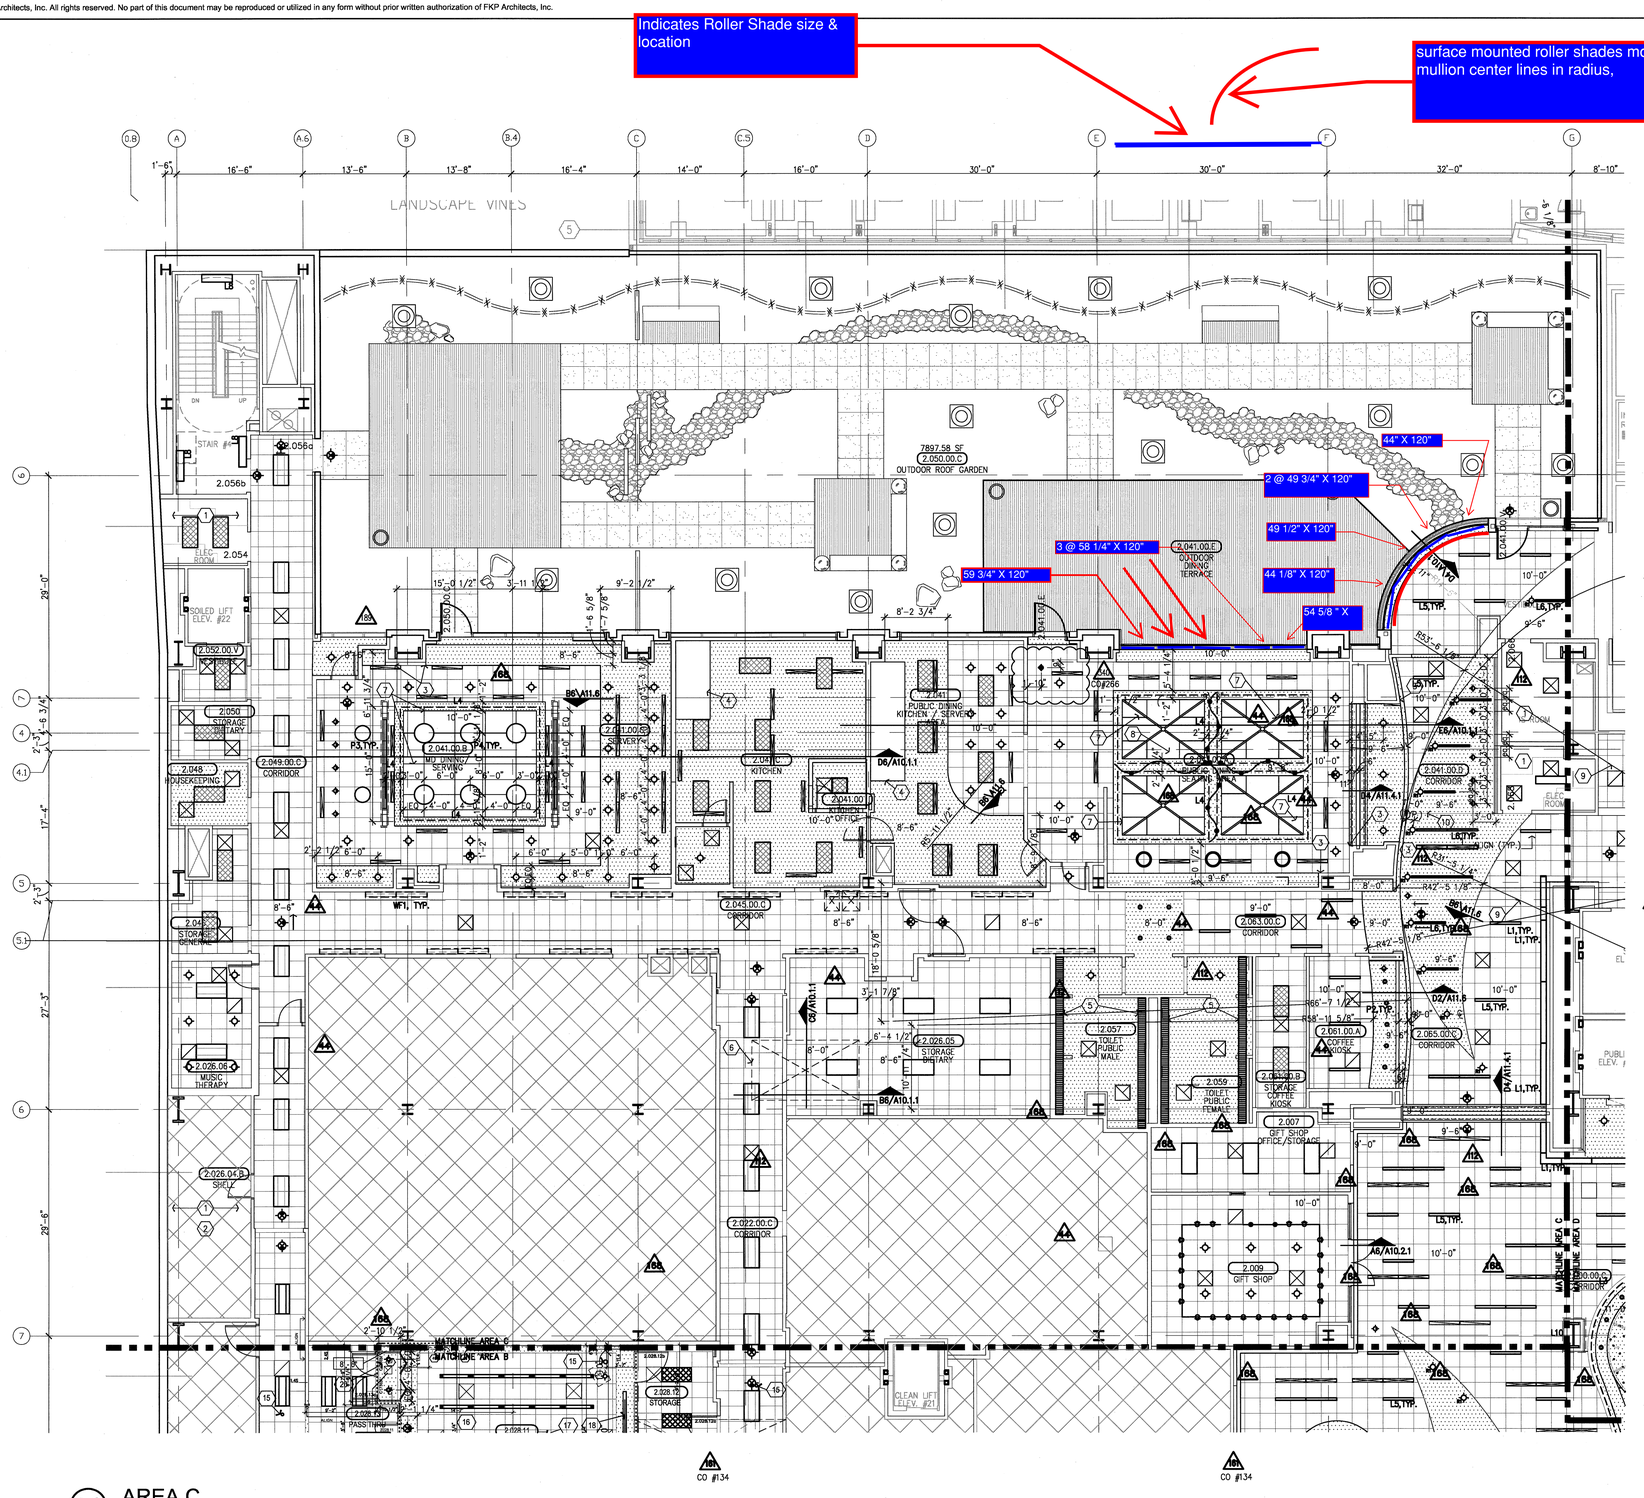

A6 AREA C
1/8" = 1'-0"

1. No ceiling, exposed structure.
2. See Electrical and Mechanical for lighting and HVAC in this space.
3. Align finished face of furr-down with finished face of partition.
4. Coordinate ceiling system with hood opening. See Kitchen drawings. See Structure for support detail.
5. Recessed light cove, see detail B3/A11.8.
6. Mechanical shaft bottom closure above. See referenced detail.
7. Decoustics Clencio panels, Claro finish. See referenced detail.
8. LED surface mounted track.
9. Please refer to sheet A4.2D for workpoint and dimensions.
10. Control joint.


A2 Notes to Sheet
N.T.S.

- X-RAY – IN USE LIGHT
- LASER – IN USE LIGHT
- EXIT LIGHT FIXTURE
- RECESSED COMPACT FLUORESCENT DOWN LIGHT
- RECESSED COMPACT FLUORESCENT DIRECTIONAL SPOT LIGHT
- WALL MOUNTED LIGHT FIXTURE
- RECESSED COMPACT FLUORESCENT DOWN LIGHT WITH DIMMER
- RECESSED EXAM LIGHT, W/ WALL MOUNTED CONTROLS
- LOUIE LIGHTING, SD–888 RECESSED LIGHT
- R2 RECESSED FIXTURE, P–8900, PRUDENTIAL LIGHTING
- P1 LOUIS POULSEN, COLLAGE PENDANT
- P2 PENDANT FIXTURE, QUEENY DOWN II, BRUCK
- P3 BOYD, 9955 ARCHETYPE PENDANT, DIMMING SATIN NICKEL
- P4 BOYD, 10217 CATACAOS PENDANT (30"), DIMMING SATIN NICKEL
- P5 CORELITE, VERTECH 2T8 4' SUSPENDED DIRECT/INDIRECT LINEAR FIXTURE
- BOA CALO SWING SPOT, BRUCK, WITH V/A TRACK, BRUCK
- BRUCK LEDRA DISPLAY TRACK AND SPOT LIGHT
- COLOR KINETICS, ICOLOR FLEX SL, TRACK MOUNTING
- COLOR KINETICS, ICOLOR FLEX SL, STRING LIGHT
- L1 INDIRECT COVE FIXTURE, P–59, PRUDENTIAL LIGHTING
- L2 PERIMETER WALL WASHER W/ ACRYLIC LENS ,FOCUS 1,FOCAL POINT
- L3 LED COVE LIGHT
- L4 FLUORESCENT COVE LIGHT
- L5 FLUORESCENT WITH FLUSH LENS, AVENUE b, FOCAL POINT
- L6 EUREKA C49169 LIGHT FIXTURE
- CEILING MOUNTED NURSE CALL INDICATOR
- L7 4" X 2' FLUORESCENT WALL MOUNTED LIGHT FIXTURE
- RECESSED FLUORESCENT LIGHT FIXTURE
- L8 1' X 4' FLUORESCENT WALL MOUNTED LIGHT FIXTURE
- L9 1' X 4' FLUORESCENT UTILITY LIGHT FIXTURE
- L10 SURFACE MOUNTED LED LIGHT
- 2' X 4' FLUORESCENT LIGHT FIXTURE WITH PARABOLIC LENS
- 2' X 4' FLUORESCENT LIGHT FIXTURE DIRECT/INDIRECT
- 2' X 4' FLUORESCENT LIGHT FIXTURE WITH PRISMATIC LENS
- MULTI FUNCTION PATIENT LIGHT FIXTURE
- SQUARE MECHANICAL GRILLES
- LINEAR MECHANICAL GRILLES
- PLASTER CEILING
- METAL PANEL SOFFIT
- GYPSUM BOARD CEILING
- OVERHEAD CABLE TRAY– SEE 15.13A FOR DETAIL
- 2' X 2' SUSPENDED ACOUSTICAL TILE
- FLUORESCENT STRIP FIXTURE
- WF1 7" X 8' 'GAMMALUX' WALL MOUNTED LIGHT FIXTURE

C1 Legend
N.T.S

A. REFER TO "FINISH SCHEDULE" FOR FURTHER DEFINITION OF CEILING MATERIALS AND FINISHES.
B. CEILING HEIGHT WILL TYPICALLY BE '9'–0"', UNLESS OTHERWISE NOTED ON THE REFLECTED CEILING PLAN.
C. LOCATE ALL CEILING MOUNTED SMOKE DETECTORS AND SPEAKERS IN THE CENTER OF FULL PANELS AT LAY–IN CEILINGS.
D. LOCATE ALL SPRINKLER HEADS IN THE CENTER OF FULL PANELS AT LAY–IN CEILINGS. AT GYPSUM BOARD CEILINGS, SYMMETRICALLY SPACE HEADS AND CENTER ON LIGHT ROWS WHERE AREA LIMITATIONS PERMIT.
E. REFER TO MEP DOCUMENTS FOR LOCATIONS OF CEILING ACCESS PANELS. UNLESS NOTED OR DETAILED OTHERWISE ACCESS PANELS IN TOILETS AND BACK OF HOUSE SPACES WITH DRYWALL OR PLASTER CEILINGS ARE TO BE PAINTED METAL. PLASTER OR DRYWALL CEILINGS WITH ACCESS PANELS IN AUTOPSY AND BODY HOLDING AREAS ARE TO BE STAINLESS STEEL.
F. FOR SEISMIC BRACING AND ANCHORAGE REQUIREMENTS FOR SUSPENDED ACOUSTICAL CEILINGS, SEE SHEET A11.10.
G. FOR SEISMIC BRACING AND ANCHORAGE REQUIREMENTS FOR SUSPENDED GYPSUM BOARD CEILINGS SEE SHEET A11.10.1.
H. GYPSUM BOARD FURRDOWN HEADERS WILL NOT BE LOWER THAN 8' A.F.F.
I. ALL CEILING MOUNTED ITEMS WITH EQUIPMENT TAGS IDENTIFIED ON EQUIPMENT SERIES SHEETS ARE CROSSED REFERENCE TO STRUCTURAL SUPPORT DETAILS VIA MATRIX SHOWN ON EQUIPMENT DRAWINGS.
J. FOR ALL LAY IN CEILING PANELS ARRANGE CEILINGS TO NOT HAVE LESS THAN ½" CEILING TILE UNLESS OTHERWISE NOTED.
K. PROVIDE 2" WIDE TRIM AT ALL PERIMETER OF ACOUSTICAL CEILING GRID SYSTEM TO MEET SEISMIC REQUIREMENTS.
L. IN THE EVENT OF A CONFLICT BETWEEN REFLECTED CEILING PLANS AND FINISH SCHEDULES, THE REQUIREMENTS OF TABLE 1224.1 CBC 2007 PART 2 SHALL GOVERN.
M. FOR O.R. DIFFUSER ARRAY, PROVIDE 2x4 SUSPENSION SYS. W/ GASKETS

B1 General Notes
N.T.S

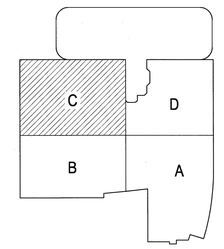

A1 KEY PLAN

FKP Architects

ARCHITECT OF RECORD
Paul C. Gloriod

LICENSED ARCHITECT MICHAEL L. SWINZ No. C 20081 STATE OF CALIFORNIA

Changes on these drawings do not consist of materially altered changes to approved drawings and don't require a change order.
OSHPD review ACO _____
OSHPD review FLSO _____
OSHPD review DSE _____

REVISIONS

4	05/28/10	ASI #08
12	10/25/10	ASI #36
68	02/04/11	ASI #57
88	03/28/10	CO #174
16	03/01/11	CO#134
240	09/05/11	CO#266

APPROVAL

Office of Statewide Health Planning & Development/FDD REVIEWED IN ACCORDANCE WITH THE REQUIREMENTS OF T24, CCR APPROVED 9/26/11

CHANGE ORDER# CO 266
INSTRUCTION BULLETIN#
DEFERRED APPROVAL#
ADDENDUM

PROJECT NAME
CHILDREN'S HOSPITAL OF ORANGE COUNTY
455 S. Main St.
Orange, CA 92868-3874

TOWER II
RECEIVED September 26 2011 McCARTHY

CHOC HOSPITAL

PROJECT NUMBER
12011.00 Increment #7

OSHPD - PROJECT NUMBER
IL 072072-30

ISSUE
OSHPD PERMIT

DATE
01/27/2010


SCALE
1/8" = 1' - 0"

DRAWING TITLE
LEVEL 2 REFLECTED CEILING PLAN AREA - C

DRAWING NUMBER
A4.2C

N:\06XXX\06102 CHOC TOWER 2 SHELL BUILDING\FKP CONTRACTED PROJECTS\PROJECT INCREMENTS\INCR. #07_TENANT IMPROVEMENT\OSHPD PERMIT (CONSTRUCTION DOCUMENTS)\06102_C07_____VA4-2D.DWG
9/9/2011
RULA

© 2009 FKP Architects, Inc. All rights reserved. No part of this document may be reproduced or utilized in any form without prior written authorization of FKP Architects, Inc.

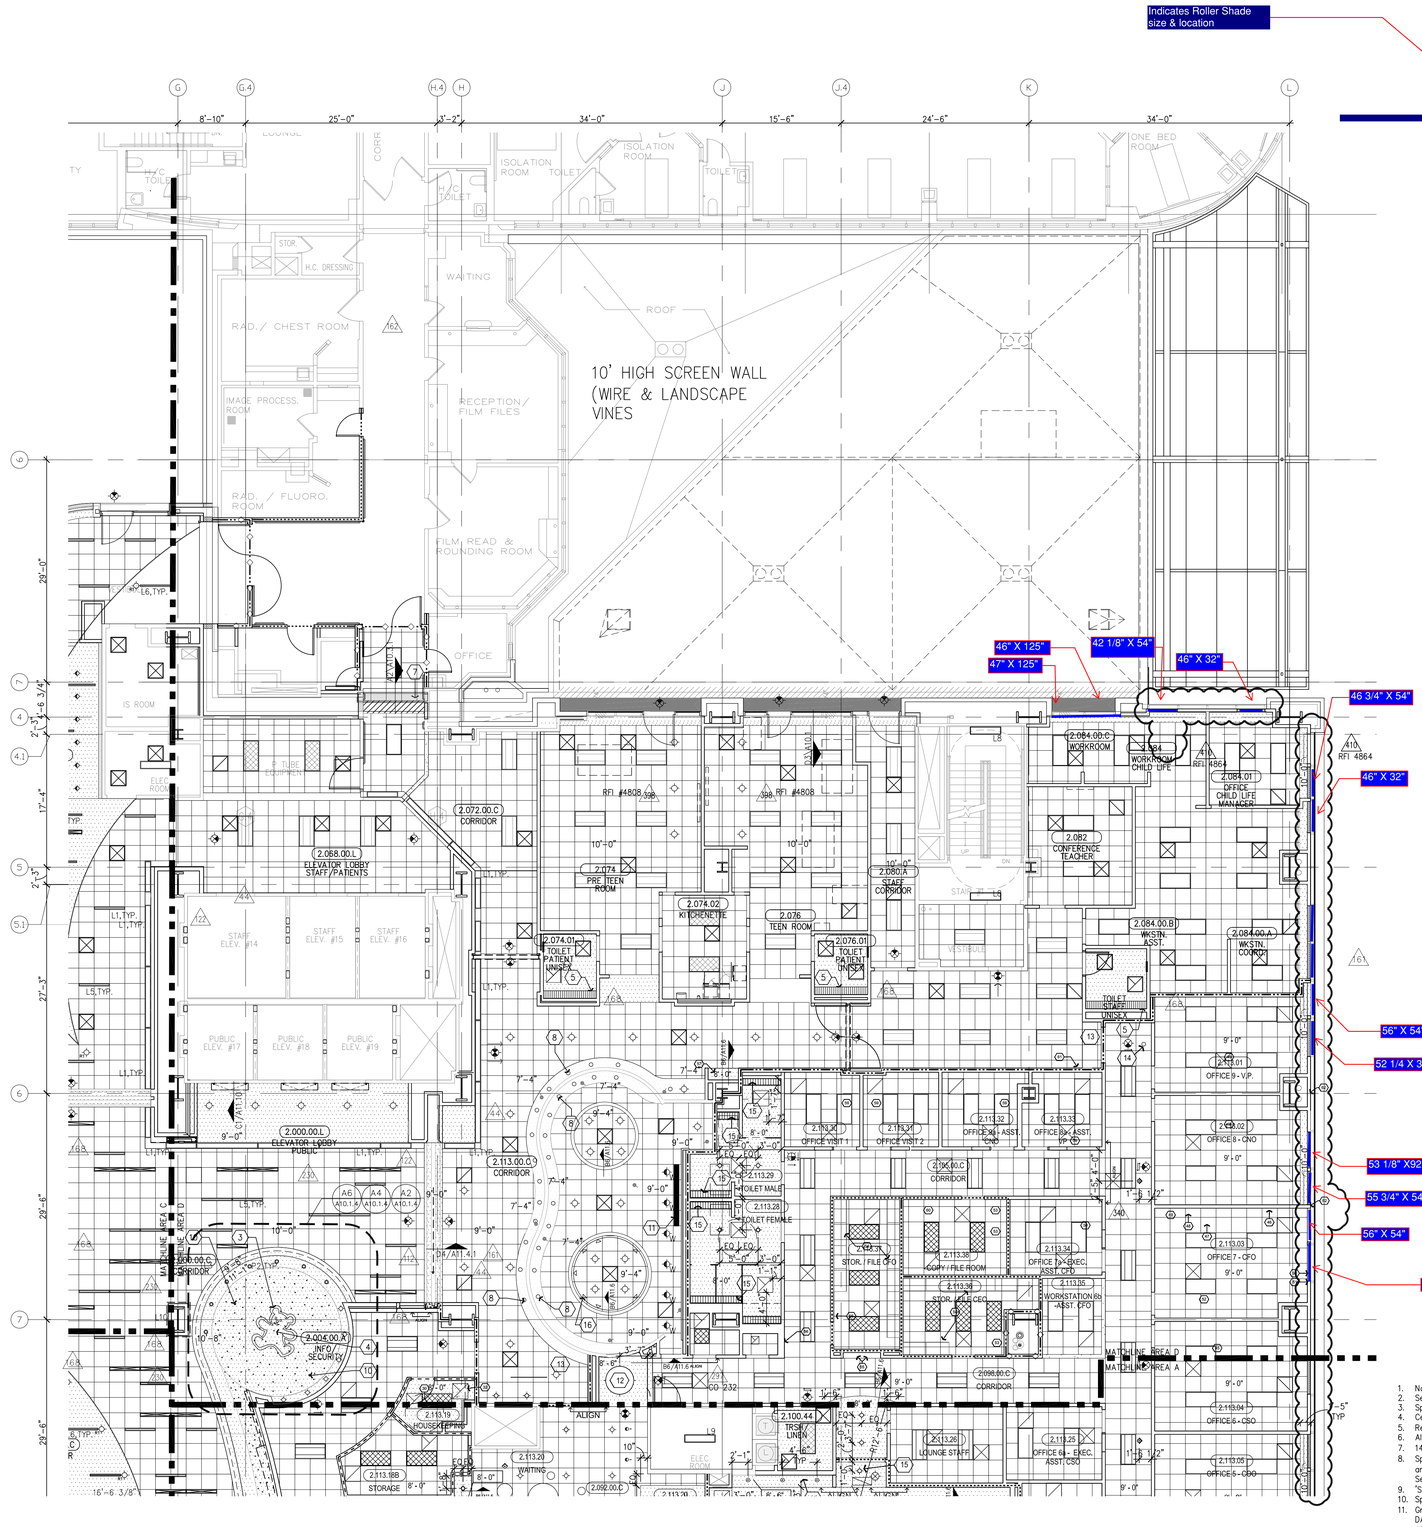

A6 AREA D
1/8" = 1'-0"

1. No ceiling, exposed structure.
2. See Electrical and Mechanical for lighting and HVAC in this space.
3. Special lighting, CHOC logo, TBD.
4. Center point, coordinate with floor and casework.
5. Recessed light cove, see detail B3/A11.8.
6. Align finished face of furr-down with finished face of partition.
7. 14" Seismic joint type 5A.
8. Sprinkler heads maximum 6'-0" O.C. between heads along protected glazing and maximum 3'-0" O.C. from edge of opening to nearest sprinkler head. See Plumbing.
9. "Smoke Guard" smoke and draft control assembly, Model 900.
10. Sprinkler head.
11. Green projection screen. Screen area 7'W x 11'H, automated, recessed. DA-LITE Advantage Deluxe Electrol. See Low Voltage, Increment #7, Volume 6D. See detail A6/A10.4
12. Locate center of light fixture with centerline of both corridors.
13. Match existing grid to provide continuous like new system.
14. Security camera, See Telecom.
15. Recessed light cove. See Detail B3/A11.8.
16. Suspended track lighting. See electrical.


A2 Notes to Sheet
N.T.S.

	LASER – IN USE LIGHT
	EXIT LIGHT FIXTURE
	RECESSED COMPACT FLUORESCENT DOWN LIGHT
CO 232	RECESSED COMPACT FLUORESCENT DIRECTIONAL SPOT LIGHT
	RECESSED LED DOWN LIGHT, WALL WASH TRIM, JUNO
	WALL MOUNTED LIGHT FIXTURE
	RECESSED COMPACT FLUORESCENT DOWN LIGHT WITH DIMMER
	RECESSED EXAM LIGHT, W/ WALL MOUNTED CONTROLS
	LOUIE LIGHTING, SD-888 RECESSED LIGHT
R2	RECESSED FIXTURE, P-8900, PRUDENTIAL LIGHTING
P1	LOUIS POULSEN, COLLAGE PENDANT
P2	PENDANT FIXTURE, QUEENY DOWN II, BRUCK
P3	BOYD, 9955 ARCHETYPE PENDANT, DIMMING SATIN NICKEL
P4	BOYD, 10217 CATACAOS PENDANT (30"), DIMMING SATIN NICKEL
P5	CORELITE, VERTECH 2T8 4' SUSPENDED DIRECT/INDIRECT LINEAR FIXTURE
	BOA CALO SWING SPOT, BRUCK, WITH V/A TRACK, BRUCK
	BRUCK LEDRA DISPLAY TRACK AND SPOT LIGHT
	COLOR KINETICS, iCOLOR FLEX SL, TRACK MOUNTING
	COLOR KINETICS, iCOLOR FLEX SL, STRING LIGHT
L1	INDIRECT COVE FIXTURE, P-59, PRUDENTIAL LIGHTING
L2	PERIMETER WALL WASHER W/ ACRYLIC LENS ,FOCUS 1,FOCAL POINT
L3	LED COVE LIGHT
L4	FLUORESCENT COVE LIGHT
L5	FLUORESCENT WITH FLUSH LENS, AVENUE b, FOCAL POINT
L6	EUREKA C49169 LIGHT FIXTURE
	CEILING MOUNTED NURSE CALL INDICATOR
L7	4" X 2' FLUORESCENT WALL MOUNTED LIGHT FIXTURE
	RECESSED FLUORESCENT LIGHT FIXTURE
L8	1' X 4' FLUORESCENT WALL MOUNTED LIGHT FIXTURE
L9	1' X 4' FLUORESCENT UTILITY LIGHT FIXTURE
L10	SURFACE MOUNTED LED LIGHT
	2' X 4' FLUORESCENT LIGHT FIXTURE WITH PARABOLIC LENS
	2' X 4' FLUORESCENT LIGHT FIXTURE DIRECT/INDIRECT
	2' X 4' FLUORESCENT LIGHT FIXTURE WITH PRISMATIC LENS
	MULTI FUNCTION PATIENT LIGHT FIXTURE
	SQUARE MECHANICAL GRILLES
	LINEAR MECHANICAL GRILLES
	PLASTER CEILING
	METAL PANEL SOFFIT
	GYPSUM BOARD CEILING
	OVERHEAD CABLE TRAY– SEE T5.13A FOR DETAIL
	2' X 2' SUSPENDED ACOUSTICAL TILE
	FLUORESCENT STRIP FIXTURE
WF1	7" X 8' "GAMMALUX" WALL MOUNTED LIGHT FIXTURE
CO 232	BUTTERFLY SPOT, BRUCK, WITH ENZIS TRACK
	MANUAL ROLLER SHADE WITH POCKET (STD. HEADBOX).
	MANUAL ROLLER SHADE WITH FASCIA/ VALENCE.

C1 Legend
N.T.S.

A. REFER TO "FINISH SCHEDULE" FOR FURTHER DEFINITION OF CEILING MATERIALS AND FINISHES.
B. CEILING HEIGHT WILL TYPICALLY BE [9'-0"], UNLESS OTHERWISE NOTED ON THE REFLECTED CEILING PLAN.
C. LOCATE ALL CEILING MOUNTED SMOKE DETECTORS AND SPEAKERS IN THE CENTER OF FULL PANELS AT LAY-IN CEILINGS.
D. LOCATE ALL SPRINKLER HEADS IN THE CENTER OF FULL PANELS AT LAY-IN CEILINGS. AT GYPSUM BOARD CEILINGS, SYMMETRICALLY SPACE HEADS AND CENTER ON LIGHT ROWS WHERE AREA LIMITATIONS PERMIT.
E. REFER TO MEP DOCUMENTS FOR LOCATIONS OF CEILING ACCESS PANELS. UNLESS NOTED OR DETAILED OTHERWISE ACCESS PANELS IN TOILETS AND BACK OF HOUSE SPACES WITH DRYWALL OR PLASTER CEILINGS ARE TO BE PAINTED METAL. PLASTER OR DRYWALL CEILINGS WITH ACCESS PANELS IN AUTOPSY AND BODY HOLDING AREAS ARE TO BE STAINLESS STEEL.
F. FOR SEISMIC BRACING AND ANCHORAGE REQUIREMENTS FOR SUSPENDED ACOUSTICAL CEILINGS, SEE SHEET A11.10.
G. FOR SEISMIC BRACING AND ANCHORAGE REQUIREMENTS FOR SUSPENDED GYPSUM BOARD CEILINGS SEE SHEET A11.10.1.
H. GYPSUM BOARD FURRDOWN HEADERS WILL NOT BE LOWER THAN 8' A.F.F.
I. ALL CEILING MOUNTED ITEMS WITH EQUIPMENT TAGS IDENTIFIED ON EQUIPMENT SERIES SHEETS ARE CROSSED REFERENCE TO STRUCTURAL SUPPORT DETAILS VIA MATRIX SHOWN ON EQUIPMENT DRAWINGS.
J. FOR ALL LAY IN CEILING PANELS ARRANGE CEILINGS TO NOT HAVE LESS THAN ½" CEILING TILE UNLESS OTHERWISE NOTED.
K. PROVIDE 2" WIDE TRIM AT ALL PERIMETER OF ACOUSTICAL CEILING GRID SYSTEM TO MEET SEISMIC REQUIREMENTS.
L. IN THE EVENT OF A CONFLICT BETWEEN REFLECTED CEILING PLANS AND FINISH SCHEDULES, THE REQUIREMENTS OF TABLE 1224.1 CBC 2007 PART 2 SHALL GOVERN.
M. FOR O.R. DIFFUSER ARRAY, PROVIDE 2x4 SUSPENSION SYS. W/ GASKETS (GORDON INC. : GC-15); HOLD DOWN CLIPS; ALUMINUM PANELS (USG: PANZ 2x4 (SMOOTH) SQUARE EDGE LAY-IN.

B1 General Notes
N.T.S.

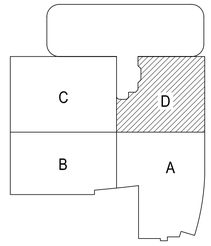

A1 KEY PLAN

FKP Architects

ARCHITECT OF RECORD
Paul C. Gloriod

LICENSED ARCHITECT MICHAEL L. SMITH NO. C 20081 REN. 1-31-13 STATE OF CALIFORNIA

Changes on these drawings do not consist of materially altered changes to approved drawings and don't require a change order.
OSHPD review ACO _____
OSHPD review FLSO _____
OSHPD review DSE _____

REVISIONS

44	05/28/10	ASI #08
122	10/20/10	CO #98
112	10/25/10	ASI 36
168	02/04/11	ASI #57
230	06/07/11	CO #181
161	03/01/11	CO#134
162	08/08/11	CO #135
340	09/05/11	CO#266
297	10/10/11	CO#232
398	12/28/11	ASI #140
410	01/09/12	ASI #156

APPROVAL

Office of Statewide Health Planning & Development/FDO REVIEWED IN ACCORDANCE WITH THE REQUIREMENTS OF T24, CCR APPROVED

CHANGE ORDER#_____
INSTRUCTION BULLETIN#_____
DEFERRED APPROVAL#_____
ADDENDUM _____

PROJECT NAME
CHILDREN'S HOSPITAL OF ORANGE COUNTY
455 S. Main St.
Orange, CA 92868-3874

TOWER II

CHOC SM HOSPITAL

PROJECT NUMBER
12011.00
Increment #7

OSHPD - PROJECT NUMBER
IL 072072-30

ISSUE
OSHPD PERMIT

DATE
01/27/2010


SCALE
1/8" = 1' - 0"

DRAWING TITLE
LEVEL 2
REFLECTED
CEILING PLAN
AREA - D

DRAWING NUMBER
A4.2D

N:\6XXX\6102 CHOC TOWER 2 SHELL BUILDING\PxP CONTRACTED PROJECTS\PROJECT INCREMENTS\INCR. #07_TENANT IMPROVEMENT\OSHPD PERMIT (CONSTRUCTION DOCUMENTS)\106602_CO#_____\A4.2D.DWG
1/24/2012
RONALD


© 2009 FKP Architects, Inc. All rights reserved. No part of this document may be reproduced or utilized in any form without prior written authorization of FKP Architects, Inc.

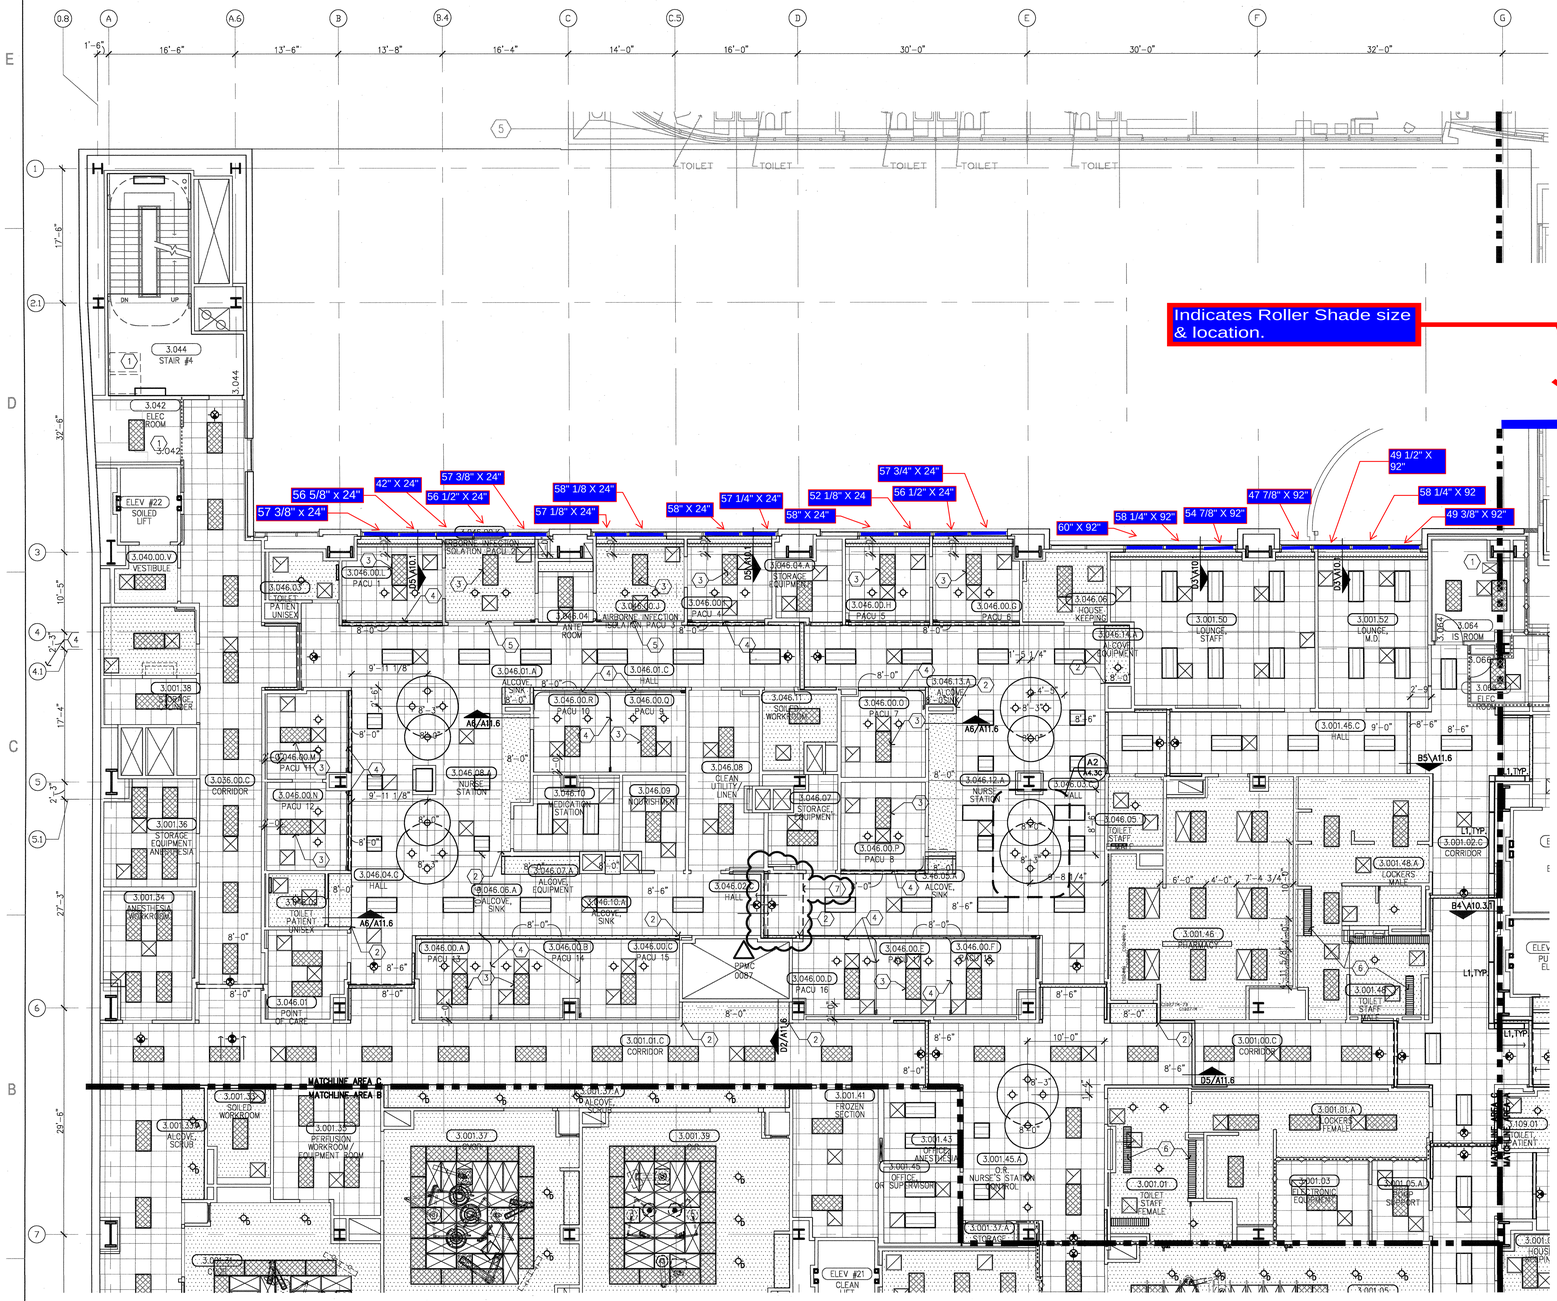


A6 AREA C
1/8" = 1'-0"

1. No ceiling, exposed to structure.
2. Align finished face of furr-down with finished face of partition.
3. Align centerline of fixture with centerline of bed. See plan.
4. Ceiling mounted curtain track behind furrdown, See detail D4/A11.8 for track detail and see B5/A11.6 for furrdown.
5. Ceiling mounted curtain track, see detail D4/A11.8
6. Light cove, see detail B3/A11.8.
7. Shaft enclosure above ceiling, see Section A6/A11.3.1.

A3 Notes To Sheet
N.T.S

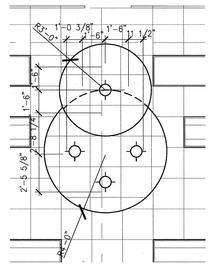

A2 Enlarged Plan
1/4" = 1'-0"

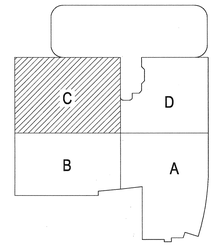

A1 KEY PLAN

- X-RAY – IN USE LIGHT
- LASER – IN USE LIGHT
- EXIT LIGHT FIXTURE
- RECESSED COMPACT FLUORESCENT DOWN LIGHT
- RECESSED COMPACT FLUORESCENT DIRECTIONAL SPOT LIGHT
- WALL MOUNTED LIGHT FIXTURE
- D RECESSED COMPACT FLUORESCENT DOWN LIGHT WITH DIMMER
- RECESSED EXAM LIGHT, W/ WALL MOUNTED CONTROLS
- LOUIE LIGHTING, SD-888 RECESSED LIGHT
- R2 RECESSED FIXTURE, P-8900, PRUDENTIAL LIGHTING
- P1 LOUIS POULSEN, COLLAGE PENDANT
- P2 PENDANT FIXTURE, QUEENY DOWN II, BRUCK
- P3 BOYD, 9955 ARCHETYPE PENDANT, DIMMING SATIN NICKEL
- P4 BOYD, 10217 CATACAOS PENDANT (30"), DIMMING SATIN NICKEL
- P5 CORELITE, VERTECH 218 4' SUSPENDED DIRECT/INDIRECT LINEAR FIXTURE
- BOA CALO SWING SPOT, BRUCK, WITH V/A TRACK, BRUCK
- BRUCK LEDRA DISPLAY TRACK AND SPOT LIGHT
- COLOR KINETICS, ICOLOR FLEX SL, TRACK MOUNTING
- COLOR KINETICS, ICOLOR FLEX SL, STRING LIGHT
- L1 INDIRECT COVE FIXTURE, P-59, PRUDENTIAL LIGHTING
- L2 PERIMETER WALL WASHER W/ ACRYLIC LENS ,FOCUS 1,FOCAL POINT
- L3 LED COVE LIGHT
- L4 FLUORESCENT COVE LIGHT
- L5 FLUORESCENT WITH FLUSH LENS, AVENUE b, FOCAL POINT
- L6 EUREKA C49169 LIGHT FIXTURE
- CEILING MOUNTED NURSE CALL INDICATOR
- L7 4" X 2' FLUORESCENT WALL MOUNTED LIGHT FIXTURE
- RECESSED FLUORESCENT LIGHT FIXTURE
- L8 1' X 4' FLUORESCENT WALL MOUNTED LIGHT FIXTURE
- L9 1' X 4' FLUORESCENT UTILITY LIGHT FIXTURE
- L10 SURFACE MOUNTED LED LIGHT
- 2' X 4' FLUORESCENT LIGHT FIXTURE WITH PARABOLIC LENS
- 2' X 4' FLUORESCENT LIGHT FIXTURE DIRECT/INDIRECT
- 2' X 4' FLUORESCENT LIGHT FIXTURE WITH PRISMATIC LENS
- MULTI FUNCTION PATIENT LIGHT FIXTURE
- SQUARE MECHANICAL GRILLES
- LINEAR MECHANICAL GRILLES
- PLASTER CEILING
- METAL PANEL SOFFIT
- GYPSUM BOARD CEILING
- OVERHEAD CABLE TRAY– SEE 15.13A FOR DETAIL
- 2' X 2' SUSPENDED ACOUSTICAL TILE

C1 Legend
N.T.S

A. REFER TO "FINISH SCHEDULE" FOR FURTHER DEFINITION OF CEILING MATERIALS AND FINISHES.
B. CEILING HEIGHT WILL TYPICALLY BE [9'-0"], UNLESS OTHERWISE NOTED ON THE REFLECTED CEILING PLAN.
C. LOCATE ALL CEILING MOUNTED SMOKE DETECTORS AND SPEAKERS IN THE CENTER OF FULL PANELS AT LAY-IN CEILINGS.
D. LOCATE ALL SPRINKLER HEADS IN THE CENTER OF FULL PANELS AT LAY-IN CEILINGS. AT GYPSUM BOARD CEILINGS, SYMMETRICALLY SPACE HEADS AND CENTER ON LIGHT ROWS WHERE AREA LIMITATIONS PERMIT.
E. REFER TO MEP DOCUMENTS FOR LOCATIONS OF CEILING ACCESS PANELS. UNLESS NOTED OR DETAILED OTHERWISE ACCESS PANELS IN TOILETS AND BACK OF HOUSE SPACES WITH DRYWALL OR PLASTER CEILINGS ARE TO BE PAINTED METAL. PLASTER OR DRYWALL CEILINGS WITH ACCESS PANELS IN AUTOPSY AND BODY HOLDING AREAS ARE TO BE STAINLESS STEEL.
F. FOR SEISMIC BRACING AND ANCHORAGE REQUIREMENTS FOR SUSPENDED ACOUSTICAL CEILINGS, SEE SHEET A11.10.
G. FOR SEISMIC BRACING AND ANCHORAGE REQUIREMENTS FOR SUSPENDED GYPSUM BOARD CEILINGS SEE SHEET A11.10.1.
H. GYPSUM BOARD FURRDOWN HEADERS WILL NOT BE LOWER THAN 8' A.F.F.
I. ALL CEILING MOUNTED ITEMS WITH EQUIPMENT TAGS IDENTIFIED ON EQUIPMENT SERIES SHEETS ARE CROSSED REFERENCE TO STRUCTURAL SUPPORT DETAILS VIA MATRIX SHOWN ON EQUIPMENT DRAWINGS.
J. FOR ALL LAY IN CEILING PANELS ARRANGE CEILINGS TO NOT HAVE LESS THAN ½" CEILING TILE UNLESS OTHERWISE NOTED.
K. PROVIDE 2" WIDE TRIM AT ALL PERIMETER OF ACOUSTICAL CEILING GRID SYSTEM TO MEET SEISMIC REQUIREMENTS.
L. IN THE EVENT OF A CONFLICT BETWEEN REFLECTED CEILING PLANS AND FINISH SCHEDULES, THE REQUIREMENTS OF TABLE 1224.1 CBC 2007 PART 2 SHALL GOVERN.

B1 General Notes
N.T.S

FKP Architects

ARCHITECT OF RECORD
Paul C. Gloriod

LICENSED ARCHITECT PAUL C. GLORIOD NO. C 20681 STATE OF CALIFORNIA

REVISIONS

	02/05/10	INFORMATION BULLETIN #5
14	05/27/10	CHANGE ORDER #14

APPROVAL

Office of Statewide Health Planning & Development (OSHPD) REVIEWED IN ACCORDANCE WITH THE REQUIREMENTS OF T24, CCR APPROVED
JUN 15 2010
CHANGE ORDER# 14
INSTRUCTION BULLETIN#
DEFERRED APPROVAL#
PROJECT NAME

CHILDREN'S HOSPITAL OF ORANGE COUNTY
455 S. Main St.
Orange, CA 92868-3874

TOWER II

CHOC SM HOSPITAL

PROJECT NUMBER
12011.00
Increment #7

OSHPD - PROJECT NUMBER
IL 072072-30

ISSUE
OSHPD PERMIT

DATE
01/27/2010


SCALE
1/8" = 1' - 0"

DRAWING TITLE
LEVEL 3
REFLECTED CEILING PLAN
AREA - C

DRAWING NUMBER
A4.3C

N:\26XXX\26102 CHOC TOWER 2 SHELL BUILDING\FKP CONTRACTED PROJECTS\PROJECT INCREMENTS\INCR. #07_TENANT IMPROVEMENT\OSHPD PERMIT (CONSTRUCTION DOCUMENTS)\102412_C0#___\A4.3C.DWG
5/21/2010
JOY


© 2009 FKP Architects, Inc. All rights reserved. No part of this document may be reproduced or utilized in any form without prior written authorization of FKP Architects, Inc.

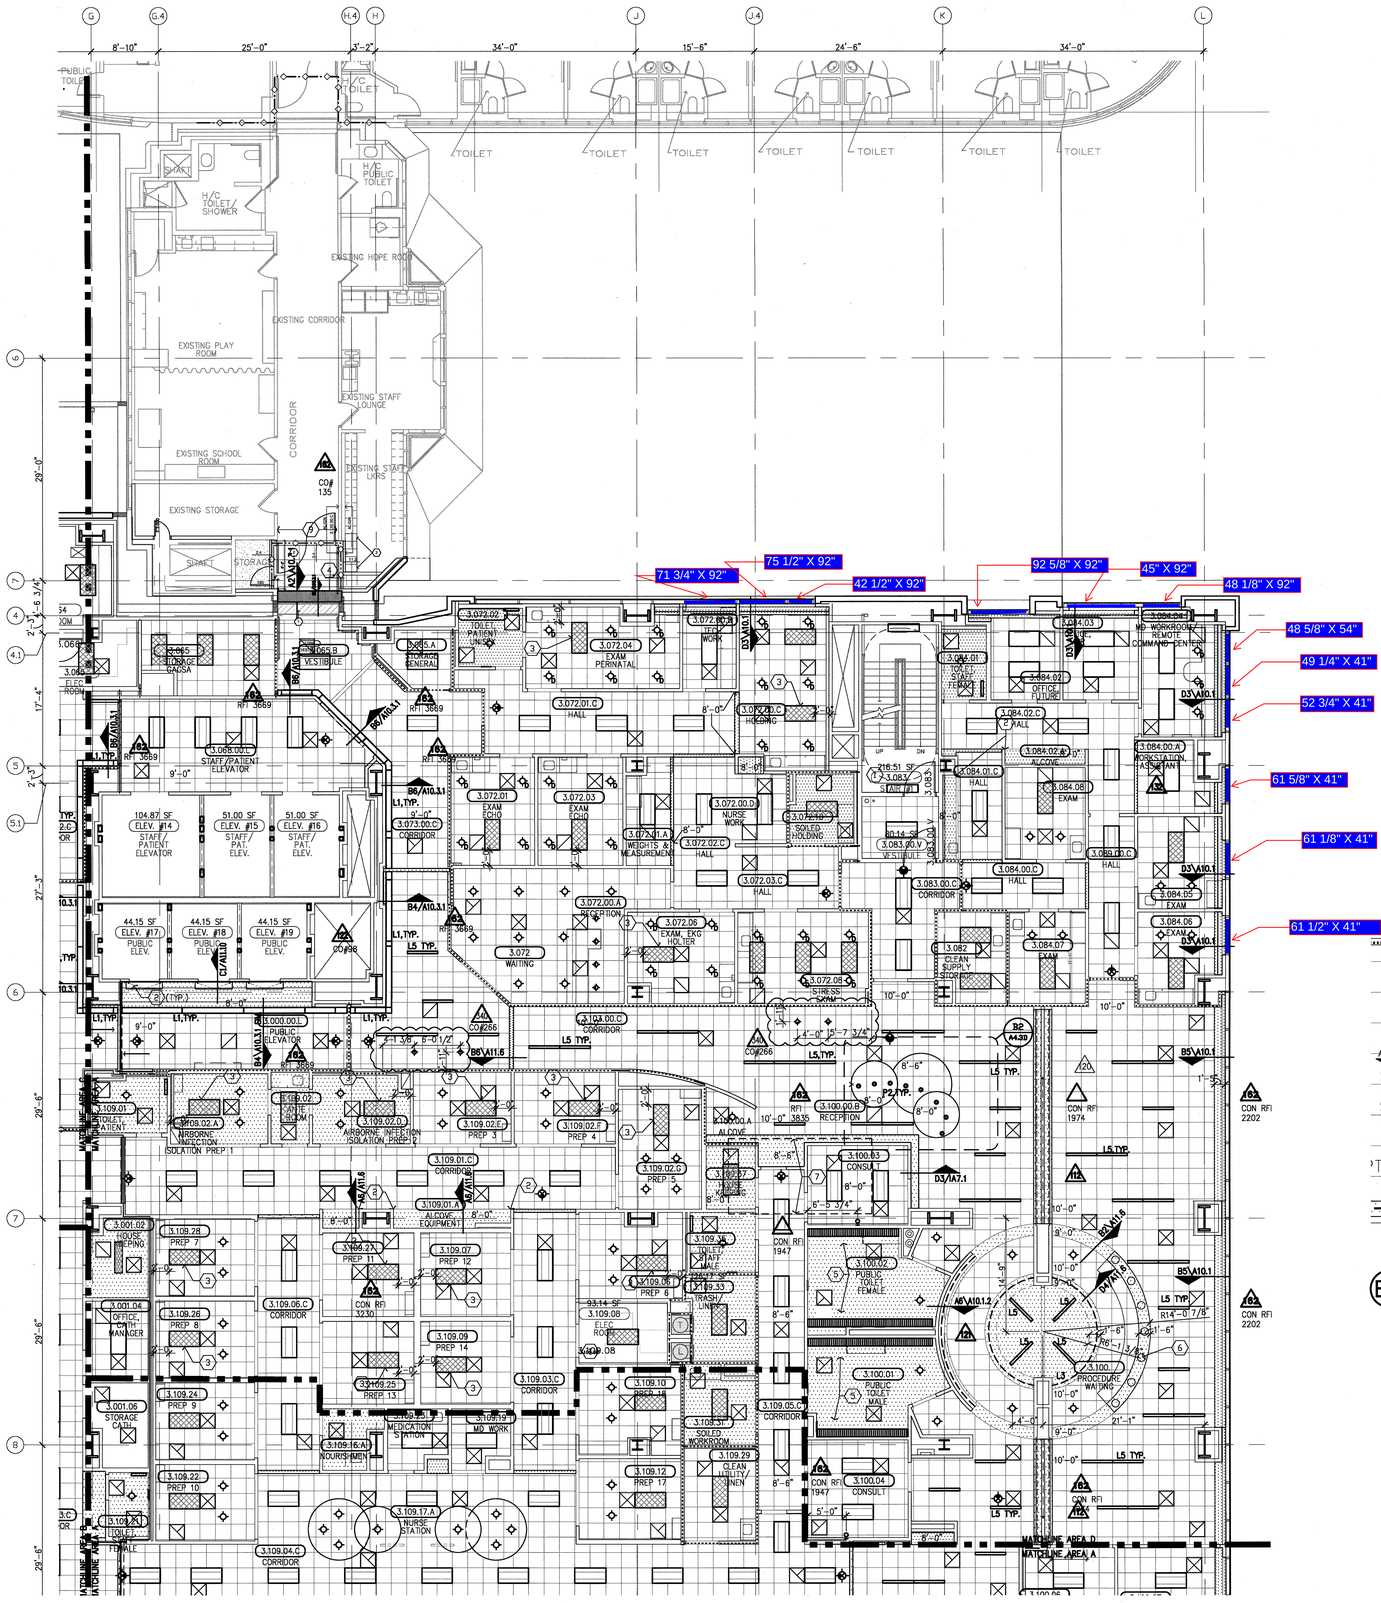

A6 AREA D
1/8" = 1'-0"

- X-RAY – IN USE LIGHT
- LASER – IN USE LIGHT
- EXIT LIGHT FIXTURE
- RECESSED COMPACT FLUORESCENT DOWN LIGHT
- RECESSED COMPACT FLUORESCENT DIRECTIONAL SPOT LIGHT
- WALL MOUNTED LIGHT FIXTURE
- RECESSED COMPACT FLUORESCENT DOWN LIGHT WITH DIMMER
- RECESSED EXAM LIGHT, W/ WALL MOUNTED CONTROLS
- LOUIE LIGHTING, SD–888 RECESSED LIGHT
- R2 RECESSED FIXTURE, P–8900, PRUDENTIAL LIGHTING
- P1 LOUIS POULSEN, COLLAGE PENDANT
- P2 PENDANT FIXTURE, QUEENY DOWN II, BRUCK
- P3 BOYD, 9955 ARCHETYPE PENDANT, DIMMING SATIN NICKEL
- P4 BOYD, 10217 CATACAOS PENDANT (30"), DIMMING SATIN NICKEL
- P5 CORELITE, VERTECH 218 4' SUSPENDED DIRECT/INDIRECT LINEAR FIXTURE
- BOA CALO SWING SPOT, BRUCK, WITH V/A TRACK, BRUCK
- BRUCK LEDRA DISPLAY TRACK AND SPOT LIGHT
- COLOR KINETICS, ICOLOR FLEX SL, TRACK MOUNTING
- COLOR KINETICS, ICOLOR FLEX SL, STRING LIGHT
- INDIRECT COVE FIXTURE, P–59, PRUDENTIAL LIGHTING
- P2 PERIMETER WALL WASHER W/ ACRYLIC LENS ,FOCUS 1,FOCAL POINT
- L3 LED COVE LIGHT
- L4 FLUORESCENT COVE LIGHT
- L5 FLUORESCENT WITH FLUSH LENS, AVENUE b, FOCAL POINT
- L6 EUREKA C49169 LIGHT FIXTURE
- CEILING MOUNTED NURSE CALL INDICATOR
- L7 4" X 2' FLUORESCENT WALL MOUNTED LIGHT FIXTURE
- RECESSED FLUORESCENT LIGHT FIXTURE
- L9 1' X 4' FLUORESCENT WALL MOUNTED LIGHT FIXTURE
- L10 1' X 4' FLUORESCENT UTILITY LIGHT FIXTURE
- SURFACE MOUNTED LED LIGHT
- 2' X 4' FLUORESCENT LIGHT FIXTURE WITH PARABOLIC LENS
- 2' X 4' FLUORESCENT LIGHT FIXTURE DIRECT/INDIRECT
- 2' X 4' FLUORESCENT LIGHT FIXTURE WITH PRISMATIC LENS
- MULTI FUNCTION PATIENT LIGHT FIXTURE
- SQUARE MECHANICAL GRILLES
- LINEAR MECHANICAL GRILLES
- PLASTER CEILING
- METAL PANEL SOFFIT
- GYPSUM BOARD CEILING
- OVERHEAD CABLE TRAY– SEE 15.13A FOR DETAIL
- 2' X 2' SUSPENDED ACOUSTICAL TILE

C1 Legend
N.T.S

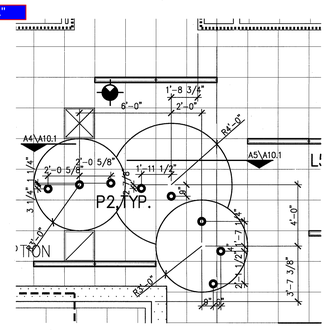


B2 Enlarged Plan
1/4" = 1'-0"

1. No ceiling, exposed to structure.
2. Align finished face of furrdown with finished face of partition.
3. Align centerline of fixture with centerline of bed. See plan.
4. 18" Seismic joint type 4A.
5. Light cove, see detail B3/A11.8.
6. Feature wall, see interiors.
7. Shaft enclosure above ceiling, see section B6/A11.3.1
8. 'Smoke Guard' smoke and draft control assembly, Model 900.
9. Modify existing ceiling as required for construction of new fire/smoke partition.

A2 Notes To Sheet
N.T.S

A. REFER TO "FINISH SCHEDULE" FOR FURTHER DEFINITION OF CEILING MATERIALS AND FINISHES.
B. CEILING HEIGHT WILL TYPICALLY BE [9'–0"], UNLESS OTHERWISE NOTED ON THE REFLECTED CEILING PLAN.
C. LOCATE ALL CEILING MOUNTED SMOKE DETECTORS AND SPEAKERS IN THE CENTER OF FULL PANELS AT LAY–IN CEILINGS.
D. LOCATE ALL SPRINKLER HEADS IN THE CENTER OF FULL PANELS AT LAY–IN CEILINGS. AT GYPSUM BOARD CEILINGS, SYMMETRICALLY SPACE HEADS AND CENTER ON LIGHT ROWS WHERE AREA LIMITATIONS PERMIT.
E. REFER TO MEP DOCUMENTS FOR LOCATIONS OF CEILING ACCESS PANELS. UNLESS NOTED OR DETAILED OTHERWISE ACCESS PANELS IN TOILETS AND BACK OF HOUSE SPACES WITH DRYWALL OR PLASTER CEILINGS ARE TO BE PAINTED METAL. PLASTER OR DRYWALL CEILINGS WITH ACCESS PANELS IN AUTOPSY AND BODY HOLDING AREAS ARE TO BE STAINLESS STEEL.
F. FOR SEISMIC BRACING AND ANCHORAGE REQUIREMENTS FOR SUSPENDED ACOUSTICAL CEILINGS, SEE SHEET A11.10.
G. FOR SEISMIC BRACING AND ANCHORAGE REQUIREMENTS FOR SUSPENDED GYPSUM BOARD CEILINGS SEE SHEET A11.10.1.
H. GYPSUM BOARD FURRDOWN HEADERS WILL NOT BE LOWER THAN 8' A.F.F.
I. ALL CEILING MOUNTED ITEMS WITH EQUIPMENT TAGS IDENTIFIED ON EQUIPMENT SERIES SHEETS ARE CROSSED REFERENCE TO STRUCTURAL SUPPORT DETAILS VIA MATRIX SHOWN ON EQUIPMENT DRAWINGS.
J. FOR ALL LAY IN CEILING PANELS ARRANGE CEILINGS TO NOT HAVE LESS THAN ½" CEILING TILE UNLESS OTHERWISE NOTED.
K. PROVIDE 2" WIDE TRIM AT ALL PERIMETER OF ACOUSTICAL CEILING GRID SYSTEM TO MEET SEISMIC REQUIREMENTS.
L. IN THE EVENT OF A CONFLICT BETWEEN REFLECTED CEILING PLANS AND FINISH SCHEDULES, THE REQUIREMENTS OF TABLE 1224.1 CBC 2007 PART 2 SHALL GOVERN.
M. FOR O.R. DIFFUSER ARRAY, PROVIDE 2x4 SUSPENSION SYS. W/ GASKETS (GORDON INC. : GC–15); HOLD DOWN CLIPS; ALUMINUM PANELS (USG: PANZ 2x4 (SMOOTH) SQUARE EDGE LAY–IN.

B1 General Notes
N.T.S

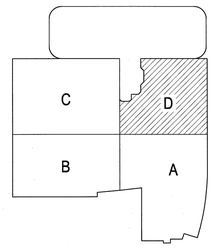

A1 KEY PLAN

FKP Architects

ARCHITECT OF RECORD
Paul C. Gloriod

LICENSED ARCHITECT MICHAEL L. BRAUN No. C 20081 STATE OF CALIFORNIA

Changes on these drawings do not consist of materially altered changes to approved drawings and don't require a change order.
OSHPD review ACO _____
OSHPD review FLSO _____
OSHPD review DSE _____

REVISIONS

44	05/28/10	ASI #08
120	10/12/10	CO #96
122	10/20/10	CO #98
12	10/25/10	ASI 36
24.3	xx/xx/11	CO #134DA
62	08/08/11	CO #135
240	09/05/11	CO#266

APPROVAL

Office of Statewide Health Planning & Development/FDD REVIEWED IN ACCORDANCE WITH THE REQUIREMENTS OF T24, CCR APPROVED NDB 9/26/11

CHANGE ORDER# CO 266
INSTRUCTION BULLETIN#_____
DEFERRED APPROVAL#_____
ADDENDUM_____

PROJECT NAME
CHILDREN'S HOSPITAL OF ORANGE COUNTY
455 S. Main St.
Orange, CA 92868-3874

TOWER II
RECEIVED
September 26 2011
McCARTHY

CHOC HOSPITAL

PROJECT NUMBER
12011.00
Increment #7

OSHPD - PROJECT NUMBER
IL 072072-30

ISSUE
OSHPD PERMIT

DATE
01/27/2010


SCALE
1/8" = 1' - 0"

DRAWING TITLE

DRAWING NUMBER
A4.3D

N:\06XX\06102 CHOC TOWER 2 SHELL BUILDING\FKP CONTRACTED PROJECTS\PROJECT INCREMENTS\INCR. #07_TENANT IMPROVEMENT\OSHPD PERMIT (CONSTRUCTION DOCUMENTS)\06602_CO#_____\A4.3D.DWG
8/30/2011
RULA

© 2009 FKP Architects, Inc. All rights reserved. No part of this document may be reproduced or utilized in any form without prior written authorization of FKP Architects, Inc.

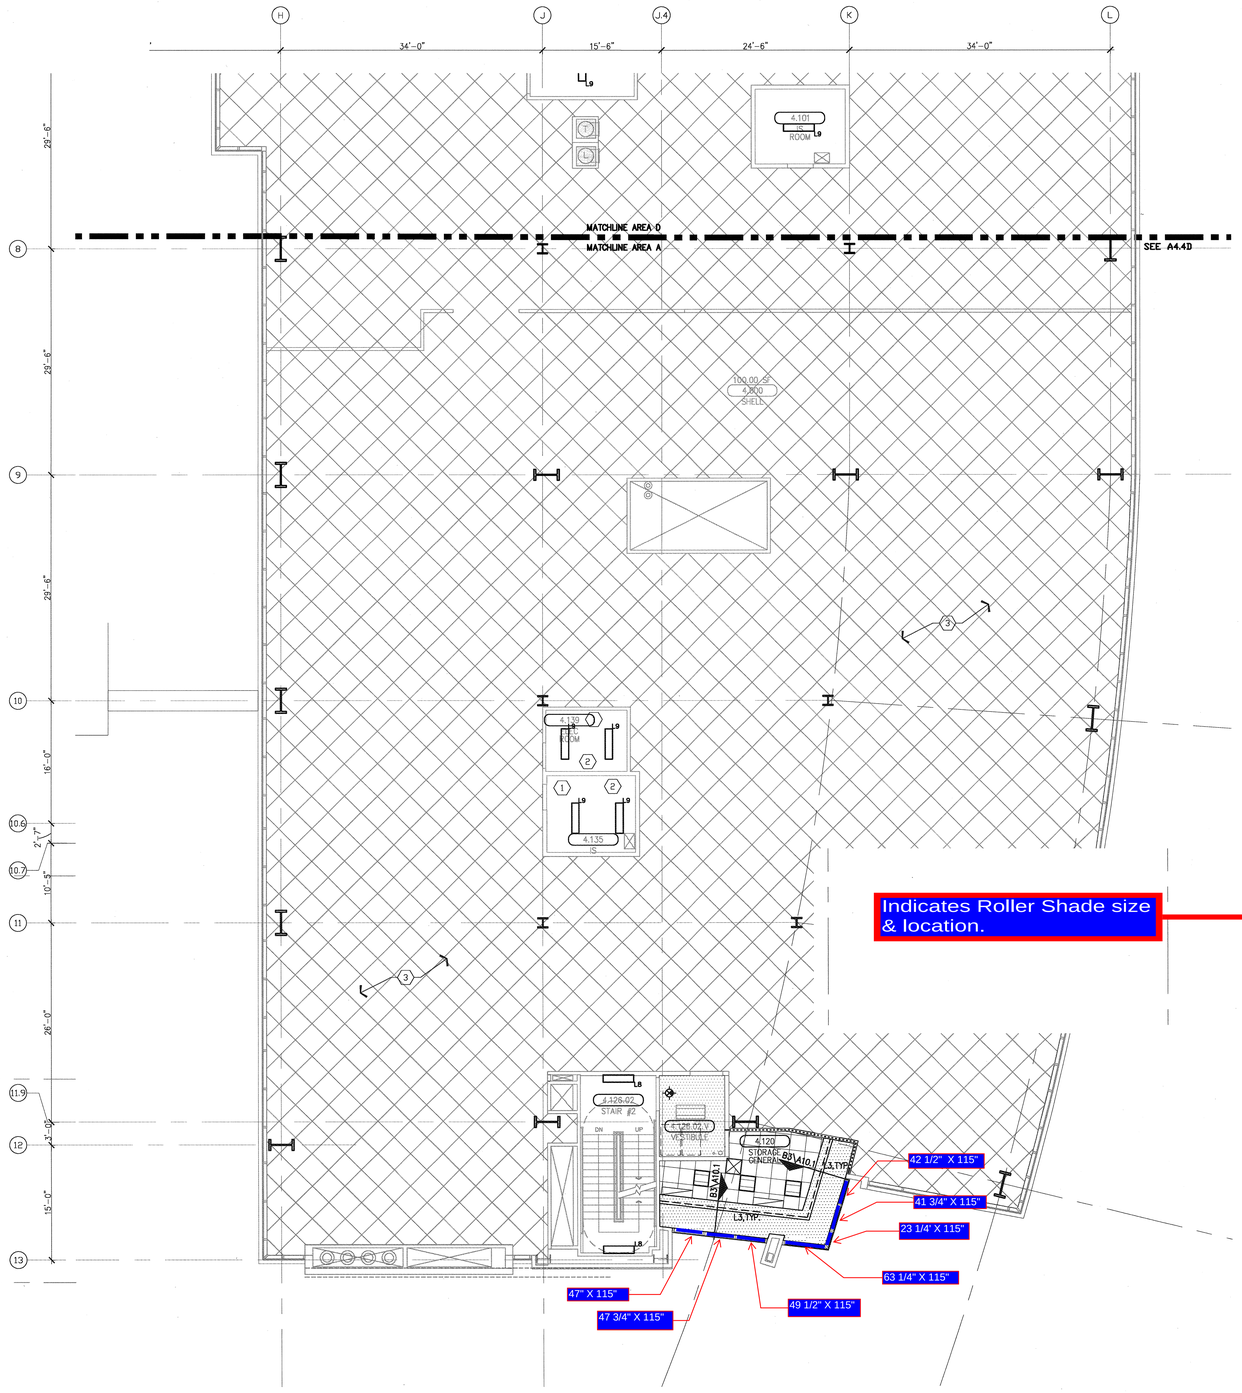

1. Wall mounted diffusers, see Mechanical drawings.
2. No ceiling, exposed to structure.
3. See Electrical and Mechanical for lighting and HVAC in this space.

A6 AREA A
1/8"=1'-0"


A2 NOTES TO SHEET

- X-RAY – IN USE LIGHT
- LASER – IN USE LIGHT
- EXIT LIGHT FIXTURE
- RECESSED COMPACT FLUORESCENT DOWN LIGHT
- RECESSED COMPACT FLUORESCENT DIRECTIONAL SPOT LIGHT
- WALL MOUNTED LIGHT FIXTURE
- D RECESSED COMPACT FLUORESCENT DOWN LIGHT WITH DIMMER
- RECESSED EXAM LIGHT, W/ WALL MOUNTED CONTROLS
- LOUIE LIGHTING, SD-888 RECESSED LIGHT
- R2 RECESSED FIXTURE, P-8900, PRUDENTIAL LIGHTING
- P1 LOUIS POULSEN, COLLAGE PENDANT
- P2 PENDANT FIXTURE, QUEENY DOWN II, BRUCK
- P3 BOYD, 9955 ARCHETYPE PENDANT, DIMMING SATIN NICKEL
- P4 BOYD, 10217 CATACAOS PENDANT (30"), DIMMING SATIN NICKEL
- P5 CORELITE, VERTECH 278 4' SUSPENDED DIRECT/INDIRECT LINEAR FIXTURE
- BOA CALO SWING SPOT, BRUCK, WITH V/A TRACK, BRUCK
- BRUCK LEDRA DISPLAY TRACK AND SPOT LIGHT
- COLOR KINETICS, ICOLOR FLEX SL, TRACK MOUNTING
- COLOR KINETICS, ICOLOR FLEX SL, STRING LIGHT
- L1 INDIRECT COVE FIXTURE, P-59, PRUDENTIAL LIGHTING
- L2 PERIMETER WALL WASHER W/ ACRYLIC LENS ,FOCUS 1,FOCAL POINT
- L3 LED COVE LIGHT
- L4 FLUORESCENT COVE LIGHT
- L5 FLUORESCENT WITH FLUSH LENS, AVENUE b, FOCAL POINT
- L6 EUREKA C49169 LIGHT FIXTURE
- CEILING MOUNTED NURSE CALL INDICATOR
- L7 4" X 2' FLUORESCENT WALL MOUNTED LIGHT FIXTURE
- RECESSED FLUORESCENT LIGHT FIXTURE
- L8 1' X 4' FLUORESCENT WALL MOUNTED LIGHT FIXTURE
- L9 1' X 4' FLUORESCENT UTILITY LIGHT FIXTURE
- L10 SURFACE MOUNTED LED LIGHT
- 2' X 4' FLUORESCENT LIGHT FIXTURE WITH PARABOLIC LENS
- 2' X 4' FLUORESCENT LIGHT FIXTURE DIRECT/INDIRECT
- 2' X 4' FLUORESCENT LIGHT FIXTURE WITH PRISMATIC LENS
- MULTI FUNCTION PATIENT LIGHT FIXTURE
- SQUARE MECHANICAL GRILLES
- LINEAR MECHANICAL GRILLES
- PLASTER CEILING
- METAL PANEL SOFFIT
- GYPSUM BOARD CEILING
- 2' X 2' SUSPENDED ACOUSTICAL TILE

C1 LEGEND

A. REFER TO "FINISH SCHEDULE" FOR FURTHER DEFINITION OF CEILING MATERIALS AND FINISHES.
B. CEILING HEIGHT WILL TYPICALLY BE [9'-0"], UNLESS OTHERWISE NOTED ON THE REFLECTED CEILING PLAN.
C. LOCATE ALL CEILING MOUNTED SMOKE DETECTORS AND SPEAKERS IN THE CENTER OF FULL PANELS AT LAY-IN CEILINGS.
D. LOCATE ALL SPRINKLER HEADS IN THE CENTER OF FULL PANELS AT LAY-IN CEILINGS. AT GYPSUM BOARD CEILINGS, SYMMETRICALLY SPACE HEADS AND CENTER ON LIGHT ROWS WHERE AREA LIMITATIONS PERMIT.
E. REFER TO MEP DOCUMENTS FOR LOCATIONS OF CEILING ACCESS PANELS. UNLESS NOTED OR DETAILED OTHERWISE ACCESS PANELS IN TOILETS AND BACK OF HOUSE SPACES WITH DRYWALL OR PLASTER CEILINGS ARE TO BE PAINTED METAL. PLASTER OR DRYWALL CEILINGS WITH ACCESS PANELS IN AUTOPSY AND BODY HOLDING AREAS ARE TO BE STAINLESS STEEL.
F. FOR SEISMIC BRACING AND ANCHORAGE REQUIREMENTS FOR SUSPENDED ACOUSTICAL CEILINGS, SEE SHEET A11.10.
G. FOR SEISMIC BRACING AND ANCHORAGE REQUIREMENTS FOR SUSPENDED GYPSUM BOARD CEILINGS SEE SHEET A11.10.1.
H. GYPSUM BOARD FURRDOWN HEADERS WILL NOT BE LOWER THAN 8' A.F.F.
I. ALL CEILING MOUNTED ITEMS WITH EQUIPMENT TAGS IDENTIFIED ON EQUIPMENT SERIES SHEETS ARE CROSSED REFERENCE TO STRUCTURAL SUPPORT DETAILS VIA MATRIX SHOWN ON EQUIPMENT DRAWINGS.
J. FOR ALL LAY IN CEILING PANELS ARRANGE CEILINGS TO NOT HAVE LESS THAN ½" CEILING TILE UNLESS OTHERWISE NOTED.
K. PROVIDE 2" WIDE TRIM AT ALL PERIMETER OF ACOUSTICAL CEILING GRID SYSTEM TO MEET SEISMIC REQUIREMENTS.
L. IN THE EVENT OF A CONFLICT BETWEEN REFLECTED CEILING PLANS AND FINISH SCHEDULES, THE REQUIREMENTS OF TABLE 1224.1 CBC 2007 PART 2 SHALL GOVERN.

B1 GENERAL NOTES

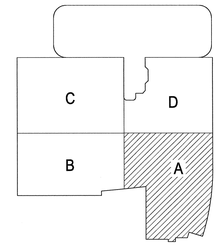

A1 KEY PLAN

FKP Architects

ARCHITECT OF RECORD
Paul C. Gloriod

LICENSED ARCHITECT
PAUL CHRISTOPHER GLORIOD
C-31500
4/30/2011
RENEWAL DATE
STATE OF CALIFORNIA
01/27/2010

REVISIONS

APPROVAL
REVIEWED IN ACCORDANCE WITH THE REQUIREMENTS OF T24, CCR
APPROVED
JAN 28 2010
Office of Statewide Health Planning & Development
FACILITIES DEVELOPMENT DIVISION

PROJECT NAME
CHILDREN'S HOSPITAL OF ORANGE COUNTY
455 S. Main St.
Orange, CA 92868-3874

TOWER II

CHOC SM HOSPITAL

PROJECT NUMBER
12011.00
Increment #7

OSHPD - PROJECT NUMBER
IL 072072-30

ISSUE
OSHPD PERMIT

DATE
01/27/2010

SCALE
1/8"=1'-0"


DRAWING TITLE
LEVEL 4
REFLECTED
CEILING PLAN
AREA - A

DRAWING NUMBER
A4.4A

C:\FKP Active\12002-00 CHOC\Sheets\Shell\A4.4A.dwg, 1/27/2010 AM 8:11A

© 2009 FKP Architects, Inc. All rights reserved. No part of this document may be reproduced or utilized in any form without prior written authorization of FKP Architects, Inc.


indicates Roller Shade size & location

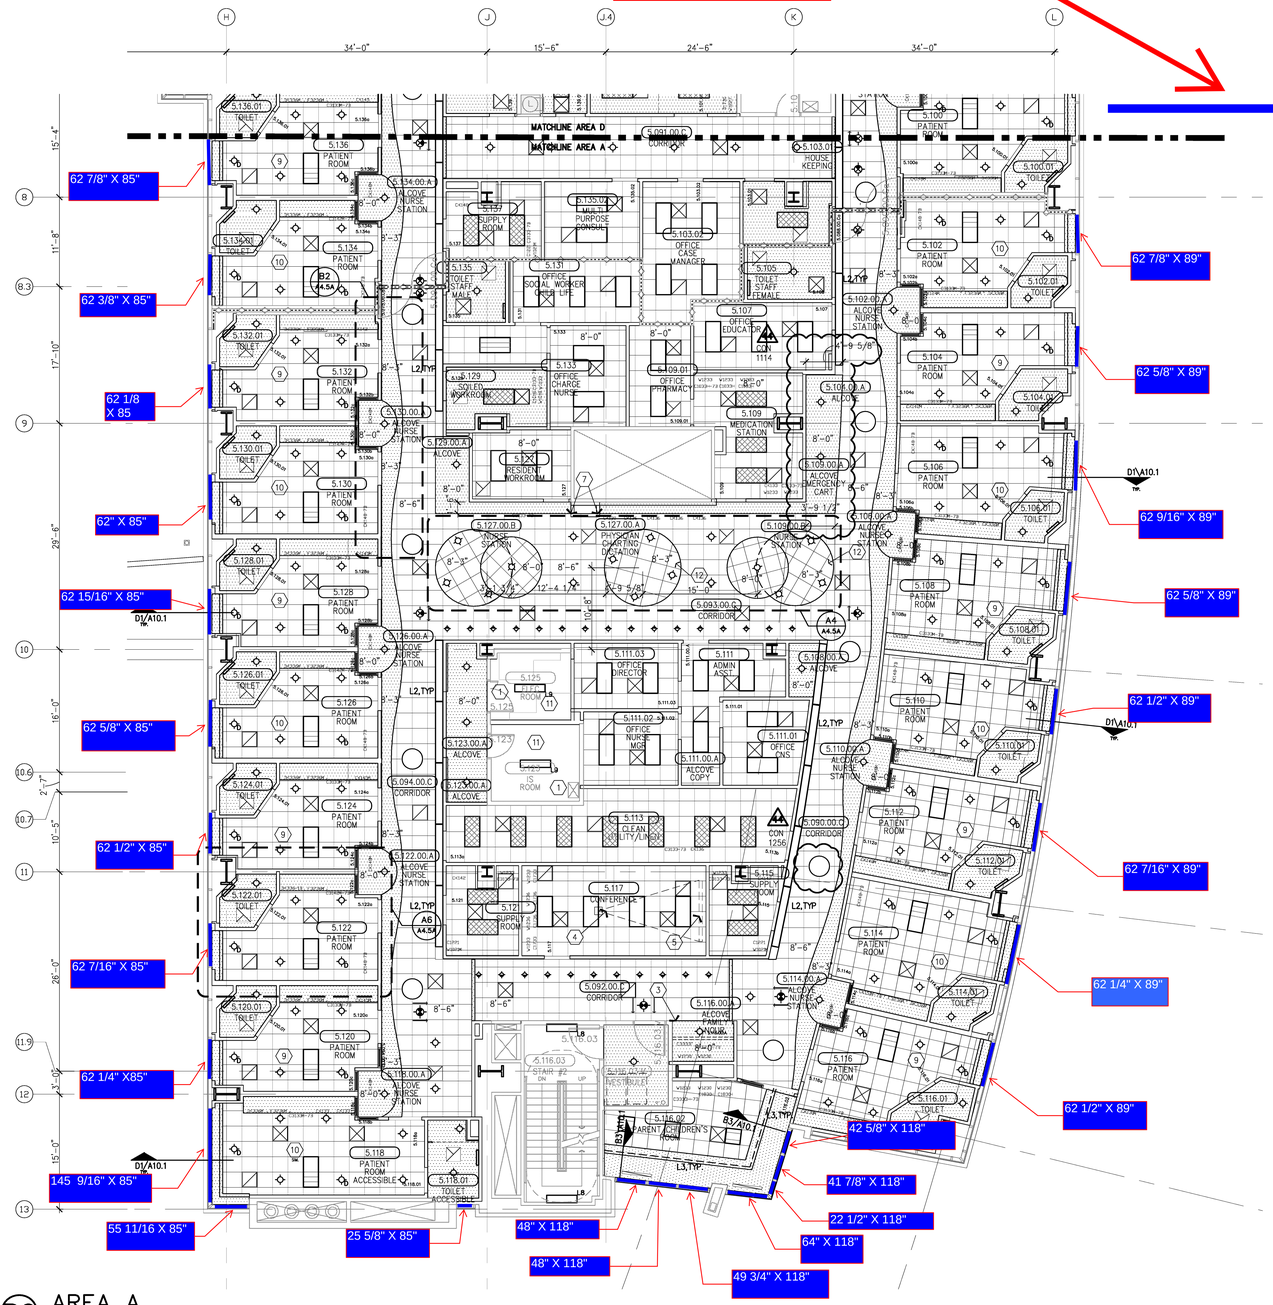

1. Wall mounted diffusers, see Mechanical drawings.
2. Align centerline of fixture with centerline of bed. See plan.
3. Roll-up shutter. See detail D2/A11.4.1.
4. Projector, ceiling mounted. See Telecom drawings.
5. Projection screen, ceiling recessed. See D3/A11.6 for detail and Telecom drawings.
6. For center location see P RCP.
7. Align finished face of soffit with finished face of partition.
8. Center point of fixture at intersection of lay-in grid, typical.
9. See A6/A4.5D for typical notes.
10. See A6/A4.5A for typical notes.
11. No ceiling, exposed to structure.
12. Suspended decorative ceiling, see detail A10.1.
13. Not used.
14. Not used.
15. Gypsum furr down.

B6 AREA A
1/8" = 1'-0"

D2 NOTES TO SHEET

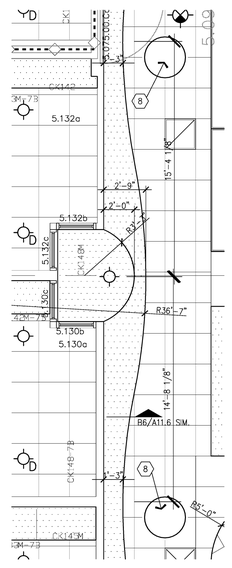


B2 TYPICAL CORRIDOR
1/4" = 1'-0"

- X-RAY – IN USE LIGHT
- LASER – IN USE LIGHT
- EXIT LIGHT FIXTURE
- RECESSED COMPACT FLUORESCENT DOWN LIGHT
- RECESSED COMPACT FLUORESCENT DIRECTIONAL SPOT LIGHT
- WALL MOUNTED LIGHT FIXTURE
- RECESSED COMPACT FLUORESCENT DOWN LIGHT WITH DIMMER
- RECESSED EXAM LIGHT, W/ WALL MOUNTED CONTROLS
- LOUIE LIGHTING, SD-888 RECESSED LIGHT
- R2 RECESSED FIXTURE, P-8900, PRUDENTIAL LIGHTING
- P1 LOUIS POULSEN, COLLAGE PENDANT
- P2 PENDANT FIXTURE, QUEENY DOWN II, BRUCK
- P3 BOYD, 9955 ARCHETYPE PENDANT, DIMMING SATIN NICKEL
- P4 BOYD, 10217 CATACAOS PENDANT (30"), DIMMING SATIN NICKEL
- P5 CORELITE, VERTECH 2T8 4' SUSPENDED DIRECT/INDIRECT LINEAR FIXTURE
- BOA CALO SWING SPOT, BRUCK, WITH V/A TRACK, BRUCK
- BRUCK LEDRA DISPLAY TRACK AND SPOT LIGHT
- COLOR KINETICS, ICOLOR FLEX SL, TRACK MOUNTING
- COLOR KINETICS, ICOLOR FLEX SL, STRING LIGHT
- L1 INDIRECT COVE FIXTURE, P-59, PRUDENTIAL LIGHTING
- L2 PERIMETER WALL WASHER W/ ACRYLIC LENS ,FOCUS 1,FOCAL POINT
- L3 LED COVE LIGHT
- L4 FLUORESCENT COVE LIGHT
- L5 FLUORESCENT WITH FLUSH LENS, AVENUE b, FOCAL POINT
- L6 EUREKA C49169 LIGHT FIXTURE
- CEILING MOUNTED NURSE CALL INDICATOR
- L7 4" X 2' FLUORESCENT WALL MOUNTED LIGHT FIXTURE
- RECESSED FLUORESCENT LIGHT FIXTURE
- L8 1' X 4' FLUORESCENT WALL MOUNTED LIGHT FIXTURE
- L9 1' X 4' FLUORESCENT UTILITY LIGHT FIXTURE
- L10 SURFACE MOUNTED LED LIGHT
- 2' X 4' FLUORESCENT LIGHT FIXTURE WITH PARABOLIC LENS
- 2' X 4' FLUORESCENT LIGHT FIXTURE DIRECT/INDIRECT
- 2' X 4' FLUORESCENT LIGHT FIXTURE WITH PRISMATIC LENS
- MULTI FUNCTION PATIENT LIGHT FIXTURE
- SQUARE MECHANICAL GRILLES
- LINEAR MECHANICAL GRILLES
- PLASTER CEILING
- METAL PANEL SOFFIT
- GYPSUM BOARD CEILING
- OVERHEAD CABLE TRAY– SEE T5.13A FOR DETAIL
- 2' X 2' SUSPENDED ACOUSTICAL TILE


C1 LEGEND

A. REFER TO "FINISH SCHEDULE" FOR FURTHER DEFINITION OF CEILING MATERIALS AND FINISHES.
B. CEILING HEIGHT WILL TYPICALLY BE [9'-0"], UNLESS OTHERWISE NOTED ON THE REFLECTED CEILING PLAN.
C. LOCATE ALL CEILING MOUNTED SMOKE DETECTORS AND SPEAKERS IN THE CENTER OF FULL PANELS AT LAY-IN CEILINGS.
D. LOCATE ALL SPRINKLER HEADS IN THE CENTER OF FULL PANELS AT LAY-IN CEILINGS. AT GYPSUM BOARD CEILINGS, SYMMETRICALLY SPACE HEADS AND CENTER ON LIGHT ROWS WHERE AREA LIMITATIONS PERMIT.
E. REFER TO MEP DOCUMENTS FOR LOCATIONS OF CEILING ACCESS PANELS. UNLESS NOTED OR DETAILED OTHERWISE ACCESS PANELS IN TOILETS AND BACK OF HOUSE SPACES WITH DRYWALL OR PLASTER CEILINGS ARE TO BE PAINTED METAL. PLASTER OR DRYWALL CEILINGS WITH ACCESS PANELS IN AUTOPSY AND BODY HOLDING AREAS ARE TO BE STAINLESS STEEL.
F. FOR SEISMIC BRACING AND ANCHORAGE REQUIREMENTS FOR SUSPENDED ACOUSTICAL CEILINGS, SEE SHEET A11.10.
G. FOR SEISMIC BRACING AND ANCHORAGE REQUIREMENTS FOR SUSPENDED GYPSUM BOARD CEILINGS SEE SHEET A11.10.1.
H. GYPSUM BOARD FURRDOWN HEADERS WILL NOT BE LOWER THAN 8' A.F.F.
I. ALL CEILING MOUNTED ITEMS WITH EQUIPMENT TAGS IDENTIFIED ON EQUIPMENT SERIES SHEETS ARE CROSSED REFERENCE TO STRUCTURAL SUPPORT DETAILS VIA MATRIX SHOWN ON EQUIPMENT DRAWINGS.
J. FOR ALL LAY IN CEILING PANELS ARRANGE CEILINGS TO NOT HAVE LESS THAN ½" CEILING TILE UNLESS OTHERWISE NOTED.
K. PROVIDE 2" WIDE TRIM AT ALL PERIMETER OF ACOUSTICAL CEILING GRID SYSTEM TO MEET SEISMIC REQUIREMENTS.
L. IN THE EVENT OF A CONFLICT BETWEEN REFLECTED CEILING PLANS AND FINISH SCHEDULES, THE REQUIREMENTS OF TABLE 1224.1 CBC 2007 PART 2 SHALL GOVERN.


B1 GENERAL NOTES

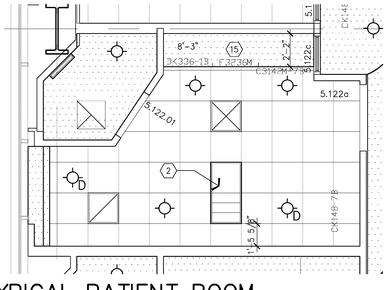

A6 TYPICAL PATIENT ROOM
1/4" = 1'-0"

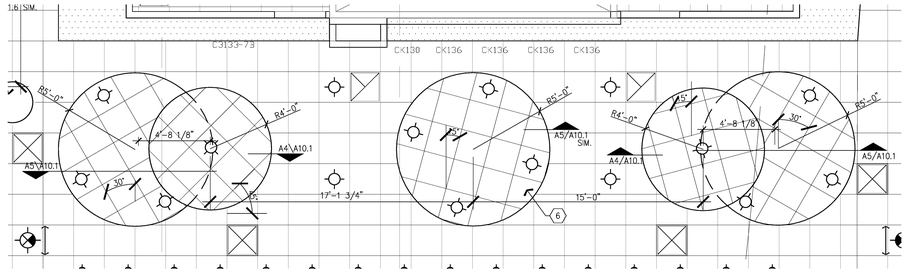

A4 CENTRAL NURSE STATION
1/4" = 1'-0"

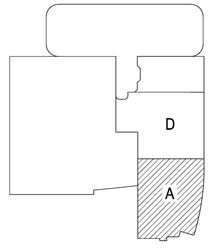

A1 KEY PLAN

FKP Architects

ARCHITECT OF RECORD
Paul C. Gloriod

LICENSED ARCHITECT
LIONEL L. SAVAL
NO. C 20081
REN. 1-31-11
STATE OF CALIFORNIA

REVISIONS

	02/05/10	INFORMATION BULLETIN #5
44	05/28/10	ASI #08

APPROVAL

PROJECT NAME
CHILDREN'S HOSPITAL OF ORANGE COUNTY
455 S. Main St.
Orange, CA 92868-3874

TOWER II

CHOC HOSPITAL

PROJECT NUMBER
12011.00
Increment #7

OSHPD - PROJECT NUMBER
IL 072072-30

ISSUE
OSHPD PERMIT

DATE
01/27/2010

SCALE
1/8" = 1'-0"

DRAWING TITLE
LEVEL 5 REFLECTED CEILING PLAN AREA - A

DRAWING NUMBER
A4.5A

\\WBSA-OFFSITE\CADSERVER\06XXX\06102 CHOC TOWER 2 SHELL BUILDING\PAP CONTRACTED PROJECTS\PROJECT INCREMENTS\INCR. #07_TENANT IMPROVEMENTS\OSHPD PERMIT (CONSTRUCTION DOCUMENTS)\100412_CO#____\A4.5A LEVEL 5 REFLECTED CEILING PLAN AREA - A.DWG
4/16/2010
ROBERT

© 2009 FKP Architects, Inc. All rights reserved. No part of this document may be reproduced or utilized in any form without prior written authorization of FKP Architects, Inc.

indicates Roller Shade size & location

1. Wall mounted diffusers, see Mechanical drawings.
2. Not used.
3. Roll-up shutter. See detail A2/A11.4.1.
4. For center location, see ⅜" RCP.
5. Not used.
6. Cubicle curtain, ceiling mounted.
7. Align finished face of soffit with finished face of partition.
8. Center point of fixture at intersection of lay-in grid, typical.
9. See A6/A4.5D for typical notes.
10. See A6/A4.5A for typical notes.
11. No ceiling, exposed to structure.
12. Suspended decorative ceiling, see detail A10.1.
13. Not used.
14. See A4/A4.5D for typical notes.
15. Align centerline of fixture with centerline of bed. See plan.
16. Drywall furr down.
17. Clerestory window. See opening schedule.
18. Surface mounted manual roller shades.
19. Security camera, ceiling mounted dome.
20. Existing expansion joint.
21. Recessed light cove. See detail B3/A11.8.

E3 NOTES TO SHEET

D2 ELECTRICAL ROOM
1/8" = 1'-0"

C2 STAIR #3
1/8" = 1'-0"

B2 NURSE STATION
1/4" = 1'-0"

B6 AREA D
1/8" = 1'-0"

A6 TYPICAL PATIENT ROOM
1/4" = 1'-0"

A4 TYPICAL ISOLATION PATIENT ROOM
1/4" = 1'-0"

A3 RECEPTION
1/4" = 1'-0"

C1 LEGEND

	LASER – IN USE LIGHT
	EXIT LIGHT FIXTURE
	RECESSED COMPACT FLUORESCENT DOWN LIGHT
	RECESSED COMPACT FLUORESCENT DIRECTIONAL SPOT LIGHT
W	RECESSED LED DOWN LIGHT, WALL WASH TRIM, JUNO
	WALL MOUNTED LIGHT FIXTURE
D	RECESSED COMPACT FLUORESCENT DOWN LIGHT WITH DIMMEF
	RECESSED EXAM LIGHT, W/ WALL MOUNTED CONTROLS
	LOUIE LIGHTING, SD–888 RECESSED LIGHT
R2	RECESSED FIXTURE, P–8900, PRUDENTIAL LIGHTING
P1	LOUIS POULSEN, COLLAGE PENDANT
P2	PENDANT FIXTURE, QUEENY DOWN II, BRUCK
P3	BOYD, 9955 ARCHETYPE PENDANT, DIMMING SATIN NICKEL
P4	BOYD, 10217 CATACAOS PENDANT (30"), DIMMING SATIN NICKEL
P5	CORELITE, VERTECH 278 4' SUSPENDED DIRECT/INDIRECT LINEAR FIXTUI
	BOA CALO SWNG SPOT, BRUCK, WITH V/A TRACK, BRUCK
	BRUCK LEDRA DISPLAY TRACK AND SPOT LIGHT
	COLOR KINETICS, iCOLOR FLEX SL, TRACK MOUNTING
	COLOR KINETICS, iCOLOR FLEX SL, STRING LIGHT
L1	INDIRECT COVE FIXTURE, P–59, PRUDENTIAL LIGHTING
L2	PERIMETER WALL WASHER W/ ACRYLIC LENS ,FOCUS 1,FOCAL POINT
L3	LED COVE LIGHT
L4	FLUORESCENT COVE LIGHT
L5	FLUORESCENT WITH FLUSH LENS, AVENUE b, FOCAL POINT
L6	EUREKA C49169 LIGHT FIXTURE
	CEILING MOUNTED NURSE CALL INDICATOR
L7	4" X 2' FLUORESCENT WALL MOUNTED LIGHT FIXTURE
	RECESSED FLUORESCENT LIGHT FIXTURE
L8	1' X 4' FLUORESCENT WALL MOUNTED LIGHT FIXTURE
L9	1' X 4' FLUORESCENT UTILITY LIGHT FIXTURE
L10	SURFACE MOUNTED LED LIGHT
	2' X 4' FLUORESCENT LIGHT FIXTURE WITH PARABOLIC LENS
	2' X 4' FLUORESCENT LIGHT FIXTURE DIRECT/INDIRECT
	2' X 4' FLUORESCENT LIGHT FIXTURE WITH PRISMATIC LENS
	MULTI FUNCTION PATIENT LIGHT FIXTURE
	SQUARE MECHANICAL GRILLES
	LINEAR MECHANICAL GRILLES
	PLASTER CEILING
	METAL PANEL SOFFIT
	GYPSUM BOARD CEILING
	OVERHEAD CABLE TRAY– SEE T5.13A FOR DETAIL
	2' X 2' SUSPENDED ACOUSTICAL TILE

B1 GENERAL NOTES

A. REFER TO "FINISH SCHEDULE" FOR FURTHER DEFINITION OF CEILING MATERIALS AND FINISHES.
B. CEILING HEIGHT WILL TYPICALLY BE [9'–0"], UNLESS OTHERWISE NOTED ON THE REFLECTED CEILING PLAN.
C. LOCATE ALL CEILING MOUNTED SMOKE DETECTORS AND SPEAKERS IN THE CENTER OF FULL PANELS AT LAY–IN CEILINGS.
D. LOCATE ALL SPRINKLER HEADS IN THE CENTER OF FULL PANELS AT LAY–IN CEILINGS. AT GYPSUM BOARD CEILINGS, SYMMETRICALLY SPACE HEADS AND CENTER ON LIGHT ROWS WHERE AREA LIMITATIONS PERMIT.
E. REFER TO MEP DOCUMENTS FOR LOCATIONS OF CEILING ACCESS PANELS. UNLESS NOTED OR DETAILED OTHERWISE ACCESS PANELS IN TOILETS AND BACK OF HOUSE SPACES WITH DRYWALL OR PLASTER CEILINGS ARE TO BE PAINTED METAL. PLASTER OR DRYWALL CEILINGS WITH ACCESS PANELS IN AUTOPSY AND BODY HOLDING AREAS ARE TO BE STAINLESS STEEL.
F. FOR SEISMIC BRACING AND ANCHORAGE REQUIREMENTS FOR SUSPENDED ACOUSTICAL CEILINGS, SEE SHEET A11.10.
G. FOR SEISMIC BRACING AND ANCHORAGE REQUIREMENTS FOR SUSPENDED GYPSUM BOARD CEILINGS SEE SHEET A11.10.1.
H. GYPSUM BOARD FURROWN HEADERS WILL NOT BE LOWER THAN 8' A.F.F.
I. ALL CEILING MOUNTED ITEMS WITH EQUIPMENT TAGS IDENTIFIED ON EQUIPMENT SERIES SHEETS ARE CROSSED REFERENCE TO STRUCTURAL SUPPORT DETAILS VIA MATRIX SHOWN ON EQUIPMENT DRAWINGS.
J. FOR ALL LAY IN CEILING PANELS ARRANGE CEILINGS TO NOT HAVE LESS THAN ½" CEILING TILE UNLESS OTHERWISE NOTED.
K. PROVIDE 2" WIDE TRIM AT ALL PERIMETER OF ACOUSTICAL CEILING GRID SYSTEM TO MEET SEISMIC REQUIREMENTS.
L. IN THE EVENT OF A CONFLICT BETWEEN REFLECTED CEILING PLANS AND FINISH SCHEDULES, THE REQUIREMENTS OF TABLE 1224.1 CBC 2007 PART 2 SHALL GOVERN.
M. FOR O.R. DIFFUSER ARRAY, PROVIDE 2x4 SUSPENSION SYS. W/ GASKETS (GORDON INC. : GC–15); HOLD DOWN CLIPS; ALUMINUM PANELS (USG: PANZ 2x4 (SMOOTH) SQUARE EDGE LAY–IN.

A1 KEY PLAN

FKP Architects

ARCHITECT OF RECORD
Paul C. Gloriod

LICENSED ARCHITECT MICHAEL P. SWAIN No. C 20061 RENEWAL 08/31/2013 STATE OF CALIFORNIA

Changes on these drawings do not consist of materially altered changes to approved drawings and don't require a change order.
OSHPD review ACO _____
OSHPD review FLSO _____
OSHPD review DSE _____

REVISIONS

28	06/16/11	ASI #95
16	08/08/11	CO #135
40	09/05/11	CO #266
39	12/23/11	ASI #131
49	03/05/12	CO #340

APPROVAL

Office of Statewide Health Planning & Development/FDD REVIEWED IN ACCORDANCE WITH THE REQUIREMENTS OF T24, CCR APPROVED
PAD 2012-02337
CHANGE ORDER# 342
INSTRUCTION BULLETIN#
DEFERRED APPROVAL#
ADDENDUM

PROJECT NAME
CHILDREN'S HOSPITAL OF ORANGE COUNTY
455 S. Main St.
Orange, CA 92868-3874

TOWER II

CHOC HOSPITAL

PROJECT NUMBER
12011.00
Increment #7

OSHPD - PROJECT NUMBER
IL 072072-30

ISSUE
OSHPD PERMIT

DATE
01/27/2010

SCALE
1/8" = 1'-0"


DRAWING TITLE
LEVEL 5 REFLECTED CEILING PLAN AREA - D-STAIR #3-ELECTRICAL ROOM

DRAWING NUMBER
A4.5D

N:\08XXX\08102 CHOC TOWER 2 SHELL BUILDING\PxP CONTRACTED PROJECTS\PROJECT INCREMENTS\INCR. #07_TENANT IMPROVEMENT\OSHPD PERMIT (CONSTRUCTION DOCUMENTS)\08602_COJ_____\A4.5D LEVEL 5 REFLECTED CEILING PLAN AREA - D.DWG
3/2/2012
JOY

© 2009 FKP Architects, Inc. All rights reserved. No part of this document may be reproduced or utilized in any form without prior written authorization of FKP Architects, Inc.

Indicates Roller Shade size & location.

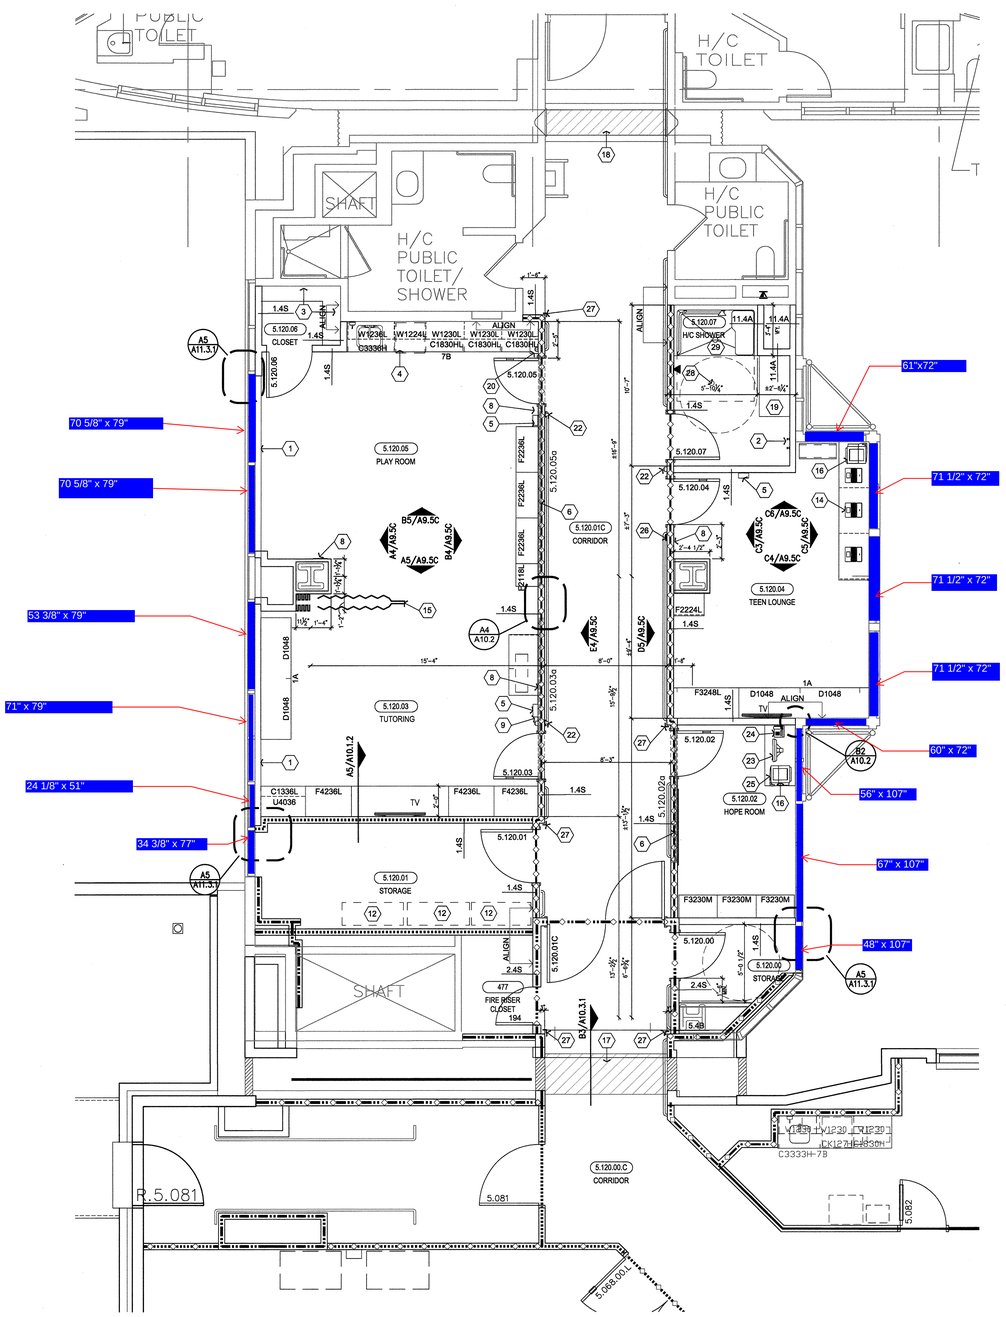

A6 AREA P
1/4" = 1'-0"


1. EXISTING ELECTRICAL RECEPTACLES TO REMAIN THIS WALL. SEE ELECTRICAL.
2. ROBE HOOK MOUNTED AT 48" A.F.F.
3. CLOSET WITH FIVE (5) – 18" DEEP ADJUSTABLE SHELVES ON HEAVY BRACKETS.
4. DISHWASHER, UNDER-COUNTER. SEE EQUIPMENT.
5. WALL MOUNTED PHONE. SEE TELECOM DRAWINGS.
6. CLEARSTORY WINDOW @ 7'-2" AFF. SEE OPENING SCHEDULE.
7. NOT USED.
8. NURSE CALL. SEE TELECOM.
9. CLOCK. SEE EQUIPMENT.
10. NOT USED.
11. NOT USED.
12. WIRE SHELVING CART. (OF/OI)
13. NOT USED
14. NOT USED
15. ACCORDION PARTITION TRACK, CEILING MOUNTED. SEE DETAILS A6/B6/A11.4.1.
16. PRINTER. SEE EQUIPMENT.
17. EXPANSION JOINT, SEE B3/A10.3.1.
18. EXISTING EXPANSION JOINT.
19. ACCESSIBLE BENCH. SEE DETAIL B2/A11.7.
20. SHARPS CONTAINER, WALL MOUNTED, SEE EQUIPMENT.
21. NOT USED.
22. VISUAL FIRE ALARM, SEE ELECTRICAL.
23. WORKSTATION. SEE EQUIPMENT.
24. PHONE, DESK MOUNTED. SEE EQUIPMENT.
25. DESK. SEE FURNITURE.
26. CARD READER. SEE SECURITY.
27. CORNER GUARD. SEE FINISHES.
28. FLOOR DRAIN, SEE PLUMBING.
29. UNCURBED ACCESSIBLE SHOWER, SEE DETAIL D3/A11.7.

D1 NOTES TO SHEET
N.T.S

A. Information shown or referenced on enlarged and/or 1/4" scale drawings will generally not be shown on the smaller scale drawings.
B. Partition types are scheduled on plans by number. See the "General Notes to Partition Types" on B2/A11.3 and Partition Types on Sheet A11.3, A11.3.1, and A11.3.2 for the definition of partition type references.
C. Field coordinate all field routed pipe, conduit runs, etc., with locations of recessed accessories and equipment. In the event of a conflict, accessory locations take precedence.
D. Close all joints between plumbing fixtures/accessories and dissimilar materials w/sealant (i.e. between sinks and countertops, toilet fixtures and accessories to wall, etc.)
E. Cabinet numbers noted on enlarged plans refer to Cabinet component numbers, fixtures, accessories, etc. that are defined or elevated on Sheet A9.0 unless specific detail references are keyed.
F. Plan dimensions – refer to B2/A11.3 (General Notes).
G. For vertical mounting heights of shower accessories, See Detail D6/A11.7.
H. For vertical mounting heights of typical toilet stall accessories, See Detail A4/A11.7.
I. For vertical mounting heights of accessible toilet stall accessories, See Detail A5/A11.7.
J. For vertical mounting heights of typical restroom accessories, See Detail B6/A11.7.
K. For vertical mounting heights of accessible accessories at restrooms, See Detail A6/A11.7.
L. For equipment not identified on plan, see Equipment drawings and workbook–Increment #7, Vol. 2E.
M. For partial enlarged plan at janitor closets, See Detail A3/A11.7.
N. Public/handicapped restroom graphics will be furnished and installed by the Owner's graphics supplier.
O. Standard equipment wall mounting heights, see detail A2/A11.9.
P. Medical equipment wall mounting heights, see details A4/A11.9, D3/A11.9 & Q0.02–Increment #7, Vol. 2E.
Q. Fire Protection equipment wall mounting heights, see detail D2/A11.9
R. Communication equipment wall mounting heights, see detail A3/A11.9.
S. Equipment mounting heights at Countertops, see detail D3/A11.9.
T. Equipment mounting heights at Desktops, see detail A4/A11.9.
U. A minimum head clearance of 6'–8" must be maintained at all points in stairways including stair and landing framing.
V. For all dashed in equipment not identified, refer to EQ drawing series–Increment #7, Vol. 2E and Equipment workbook. Specific items requiring structural support are cross referenced to structural support details via matrix shown on the Equipment drawings–Increment #7, Vol. 2E.
W. All elevator hoist way entrance frames to have an embossed stainless steel graphic plaque with the floor landing number and Standard Braille markings for the blind. Conform to governing Accessibility codes and standards.
X. All stair floor landings to receive stencil painted, semi-gloss enamel floor landing numerals 12" high adjacent to the door at 5'–0" AFF in a contrasting color to the scheduled wall color unless a graphic plaque is specifically detailed or noted.
Y. Elevator Equipment Wall Mounting Heights, see detail A6/A11.9 and B3/A11.9.
Z. Doors, Frames, Sidelites and Windows: (See Door Schedule). See A11 sheet series.
AA. Provide wall blocking/backing for items weighting 20lbs or less. See A6/A11.3.1.
BB. For personal effects storage unit types and sizes see A4/A11.8.
CC. For typical equipment backing support, see A4/S1.1–Increment #5.
DD. For boundaries of alternates and phasing, see the AP drawing series.
EE. Provide 3" grommet, unless otherwise noted at 3'–0" O.C. maximum, field located at all electrical components at Nurses stations and Reception desks.
FF. For vertical mounting heights of service accessories, See Detail A3/A11.
GG. Provide access panels below the Patient Room countertops to serve as inspection ports for the Patient Room bathtubs.

B1 GENERAL NOTES
N.T.S

A1 KEY PLAN

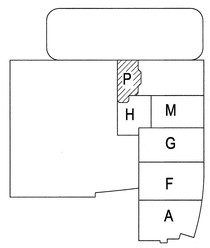

FKP Architects

ARCHITECT OF RECORD
Paul C. Gloriod

LICENSED ARCHITECT MICHAEL L. SIMON NO. C 20081 RENEWAL 11-30-11 STATE OF CALIFORNIA

Changes on these drawings do not consist of materially altered changes to approved drawings and don't require a change order.
OSHPD review ACO _____
OSHPD review FLSO _____
OSHPD review DSE _____

REVISIONS

62	08/08/11	CO #135

APPROVAL

Office of Statewide Health Planning & Development/DO REVIEWED IN ACCORDANCE WITH THE REQUIREMENTS OF T24, CCR APPROVED

CHANGE ORDER# 135
INSTRUCTION BULLETIN# _____
DEFERRED APPROVAL# _____
ADDENDUM _____

PROJECT NAME
CHILDREN'S HOSPITAL OF ORANGE COUNTY
455 S. Main St.
Orange, CA 92868-3874

TOWER II

RECEIVED
SEPT. 21 2011
McCARTHY

CHOC HOSPITAL

PROJECT NUMBER
12011.00
Increment #7

OSHPD - PROJECT NUMBER
IL 072072-30

ISSUE
OSHPD PERMIT

DATE
01/27/2010

SCALE
1/4"=1'


DRAWING TITLE
LEVEL 5 ENLARGED PLAN - AREA P

DRAWING NUMBER
A3.5P
62

Y:\MCR_ #07_TENANT IMPROVEMENT\OSHPD PERMIT (CONSTRUCTION DOCUMENTS)\100602_CO3_____\CO 135\CHANGE ORDER 135 - A3.5P.DWG
8/4/2011
JGOODMAN

© 2009 FKP Architects, Inc. All rights reserved. No part of this document may be reproduced or utilized in any form without prior written authorization of FKP Architects, Inc.

Indicates Roller Shade size & location.

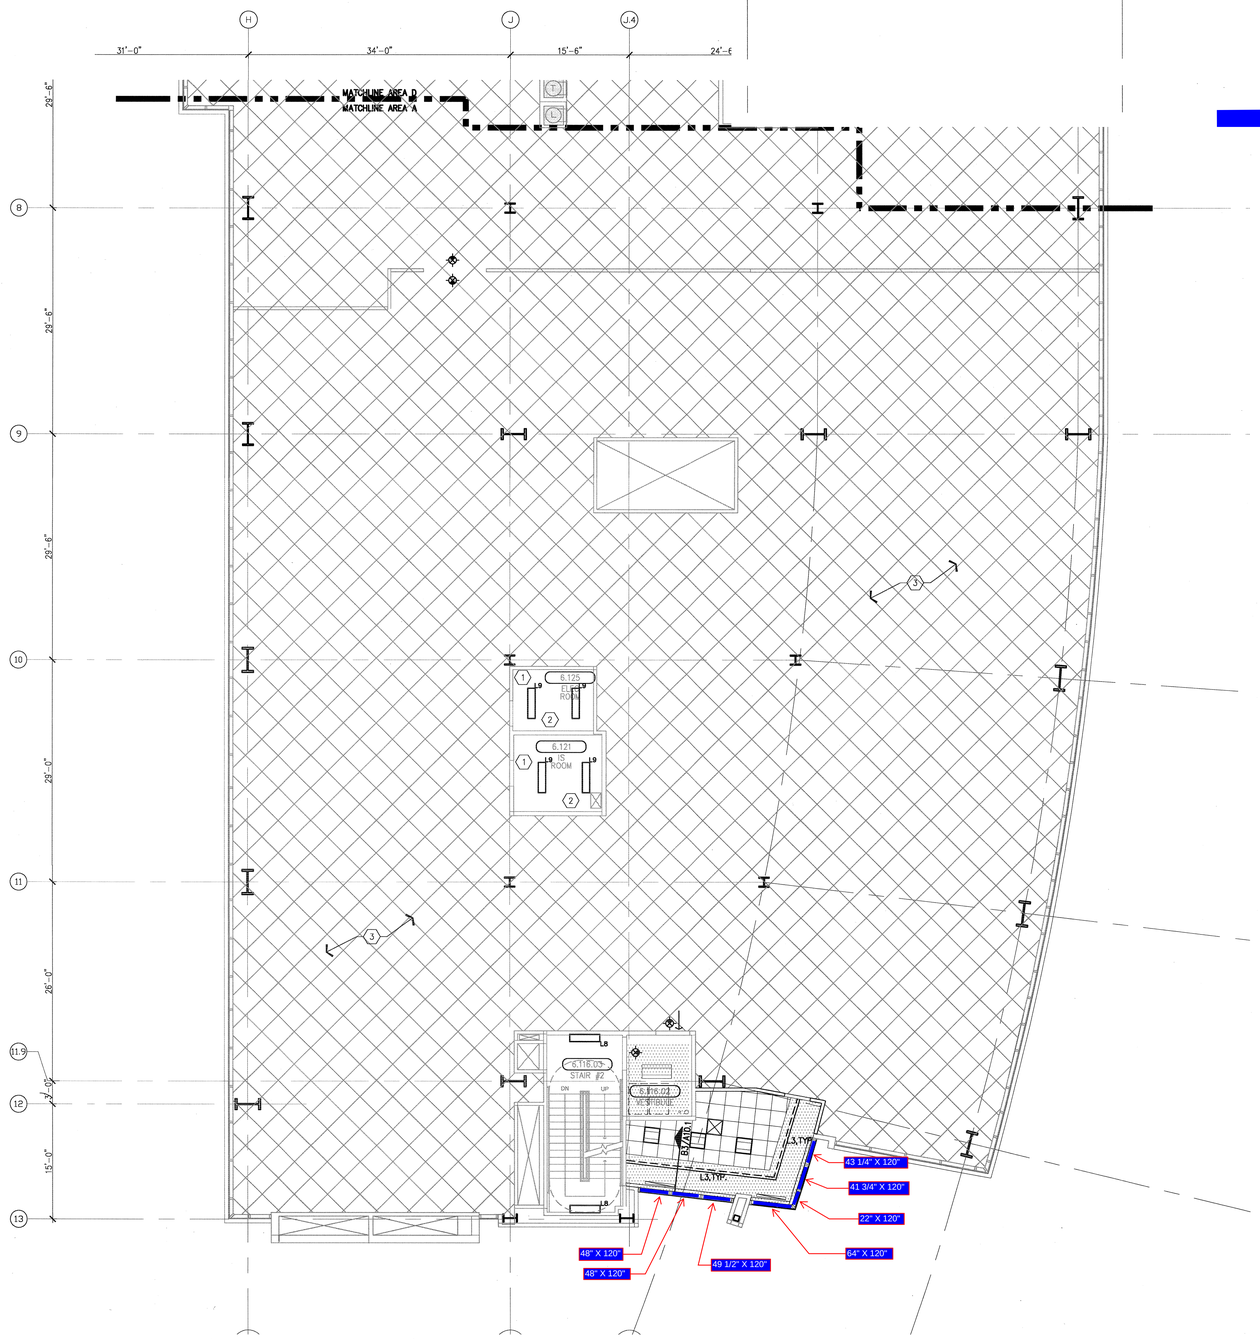

A6 AREA A
1/8" = 1'-0"

- X-RAY – IN USE LIGHT
- LASER – IN USE LIGHT
- EXIT LIGHT FIXTURE
- RECESSED COMPACT FLUORESCENT DOWN LIGHT
- RECESSED COMPACT FLUORESCENT DIRECTIONAL SPOT LIGHT
- WALL MOUNTED LIGHT FIXTURE
- D — RECESSED COMPACT FLUORESCENT DOWN LIGHT WITH DIMMER
- RECESSED EXAM LIGHT, W/ WALL MOUNTED CONTROLS
- LOUIE LIGHTING, SD–888 RECESSED LIGHT
- R2 — RECESSED FIXTURE, P–8900, PRUDENTIAL LIGHTING
- P1 — LOUIS POULSEN, COLLAGE PENDANT
- P2 — PENDANT FIXTURE, QUEENY DOWN II, BRUCK
- P3 — BOYD, 9955 ARCHETYPE PENDANT, DIMMING SATIN NICKEL
- P4 — BOYD, 10217 CATACAOS PENDANT (30"), DIMMING SATIN NICKEL
- P5 — CORELITE, VERTECH 278 4' SUSPENDED DIRECT/INDIRECT LINEAR FIXTURE
- BOA CALO SWING SPOT, BRUCK, WITH V/A TRACK, BRUCK
- BRUCK LEDRA DISPLAY TRACK AND SPOT LIGHT
- COLOR KINETICS, ICOLOR FLEX SL, TRACK MOUNTING
- COLOR KINETICS, ICOLOR FLEX SL, STRING LIGHT
- L1 — INDIRECT COVE FIXTURE, P–59, PRUDENTIAL LIGHTING
- L2 — PERIMETER WALL WASHER W/ ACRYLIC LENS ,FOCUS 1,FOCAL POINT
- L3 — LED COVE LIGHT
- L4 — FLUORESCENT COVE LIGHT
- L5 — FLUORESCENT WITH FLUSH LENS, AVENUE b, FOCAL POINT
- L6 — EUREKA C49169 LIGHT FIXTURE
- CEILING MOUNTED NURSE CALL INDICATOR
- L7 — 4" X 2' FLUORESCENT WALL MOUNTED LIGHT FIXTURE
- RECESSED FLUORESCENT LIGHT FIXTURE
- L8 — 1' X 4' FLUORESCENT WALL MOUNTED LIGHT FIXTURE
- L9 — 1' X 4' FLUORESCENT UTILITY LIGHT FIXTURE
- L10 — SURFACE MOUNTED LED LIGHT
- 2' X 4' FLUORESCENT LIGHT FIXTURE WITH PARABOLIC LENS
- 2' X 4' FLUORESCENT LIGHT FIXTURE DIRECT/INDIRECT
- 2' X 4' FLUORESCENT LIGHT FIXTURE WITH PRISMATIC LENS
- MULTI FUNCTION PATIENT LIGHT FIXTURE
- SQUARE MECHANICAL GRILLES
- LINEAR MECHANICAL GRILLES
- PLASTER CEILING
- METAL PANEL SOFFIT
- GYPSUM BOARD CEILING
- 2' X 2' SUSPENDED ACOUSTICAL TILE


C1 LEGEND
N.T.S

A. REFER TO "FINISH SCHEDULE" FOR FURTHER DEFINITION OF CEILING MATERIALS AND FINISHES.
B. CEILING HEIGHT WILL TYPICALLY BE [9'-0"], UNLESS OTHERWISE NOTED ON THE REFLECTED CEILING PLAN.
C. LOCATE ALL CEILING MOUNTED SMOKE DETECTORS AND SPEAKERS IN THE CENTER OF FULL PANELS AT LAY–IN CEILINGS.
D. LOCATE ALL SPRINKLER HEADS IN THE CENTER OF FULL PANELS AT LAY–IN CEILINGS. AT GYPSUM BOARD CEILINGS, SYMMETRICALLY SPACE HEADS AND CENTER ON LIGHT ROWS WHERE AREA LIMITATIONS PERMIT.
E. REFER TO MEP DOCUMENTS FOR LOCATIONS OF CEILING ACCESS PANELS. UNLESS NOTED OR DETAILED OTHERWISE ACCESS PANELS IN TOILETS AND BACK OF HOUSE SPACES WITH DRYWALL OR PLASTER CEILINGS ARE TO BE PAINTED METAL. PLASTER OR DRYWALL CEILINGS WITH ACCESS PANELS IN AUTOPSY AND BODY HOLDING AREAS ARE TO BE STAINLESS STEEL.
F. FOR SEISMIC BRACING AND ANCHORAGE REQUIREMENTS FOR SUSPENDED ACOUSTICAL CEILINGS, SEE SHEET A11.10.
G. FOR SEISMIC BRACING AND ANCHORAGE REQUIREMENTS FOR SUSPENDED GYPSUM BOARD CEILINGS SEE SHEET A11.10.1.
H. GYPSUM BOARD FURRDOWN HEADERS WILL NOT BE LOWER THAN 8' A.F.F.
I. ALL CEILING MOUNTED ITEMS WITH EQUIPMENT TAGS IDENTIFIED ON EQUIPMENT SERIES SHEETS ARE CROSSED REFERENCE TO STRUCTURAL SUPPORT DETAILS VIA MATRIX SHOWN ON EQUIPMENT DRAWINGS.
J. FOR ALL LAY IN CEILING PANELS ARRANGE CEILINGS TO NOT HAVE LESS THAN ½" CEILING TILE UNLESS OTHERWISE NOTED.
K. PROVIDE 2" WIDE TRIM AT ALL PERIMETER OF ACOUSTICAL CEILING GRID SYSTEM TO MEET SEISMIC REQUIREMENTS.
L. IN THE EVENT OF A CONFLICT BETWEEN REFLECTED CEILING PLANS AND FINISH SCHEDULES, THE REQUIREMENTS OF TABLE 1224.1 CBC 2007 PART 2 SHALL GOVERN.

B1 GENERAL NOTES
N.T.S

1. Wall mounted diffusers, see Mechanical drawings.
2. No ceiling, exposed to structure.
3. See Electrical and Mechanical for lighting and HVAC in this space.

A2 NOTES TO SHEET

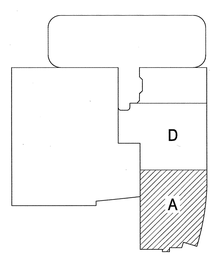

A1 KEY PLAN

FKP Architects

ARCHITECT OF RECORD
Paul C. Gloriod

LICENSED ARCHITECT
PAUL CHRISTOPHER GLORIOD
C-31500
4/30/2011
RENEWAL DATE
STATE OF CALIFORNIA
01/27/2010

REVISIONS

APPROVAL

REVIEWED IN ACCORDANCE WITH THE REQUIREMENTS OF T24, CCR
APPROVED
JAN 28 2010
Office of Statewide Health Planning & Development
FACILITIES DEVELOPMENT DIVISION

PROJECT NAME
CHILDREN'S HOSPITAL OF ORANGE COUNTY
455 S. Main St.
Orange, CA 92868-3874

TOWER II

CHOC SM HOSPITAL

PROJECT NUMBER
12011.00
Increment #7

OSHPD - PROJECT NUMBER
IL 072072-30

ISSUE
OSHPD PERMIT

DATE
01/27/2010

SCALE
1/8" = 1' - 0"


DRAWING TITLE
LEVEL 6
REFLECTED
CEILING PLAN
AREA - A

DRAWING NUMBER
A4.6A

1/25/2010
AMEHTA

© 2009 FKP Architects, Inc. All rights reserved. No part of this document may be reproduced or utilized in any form without prior written authorization of FKP Architects, Inc.

Indicates Roller Shade size & location.

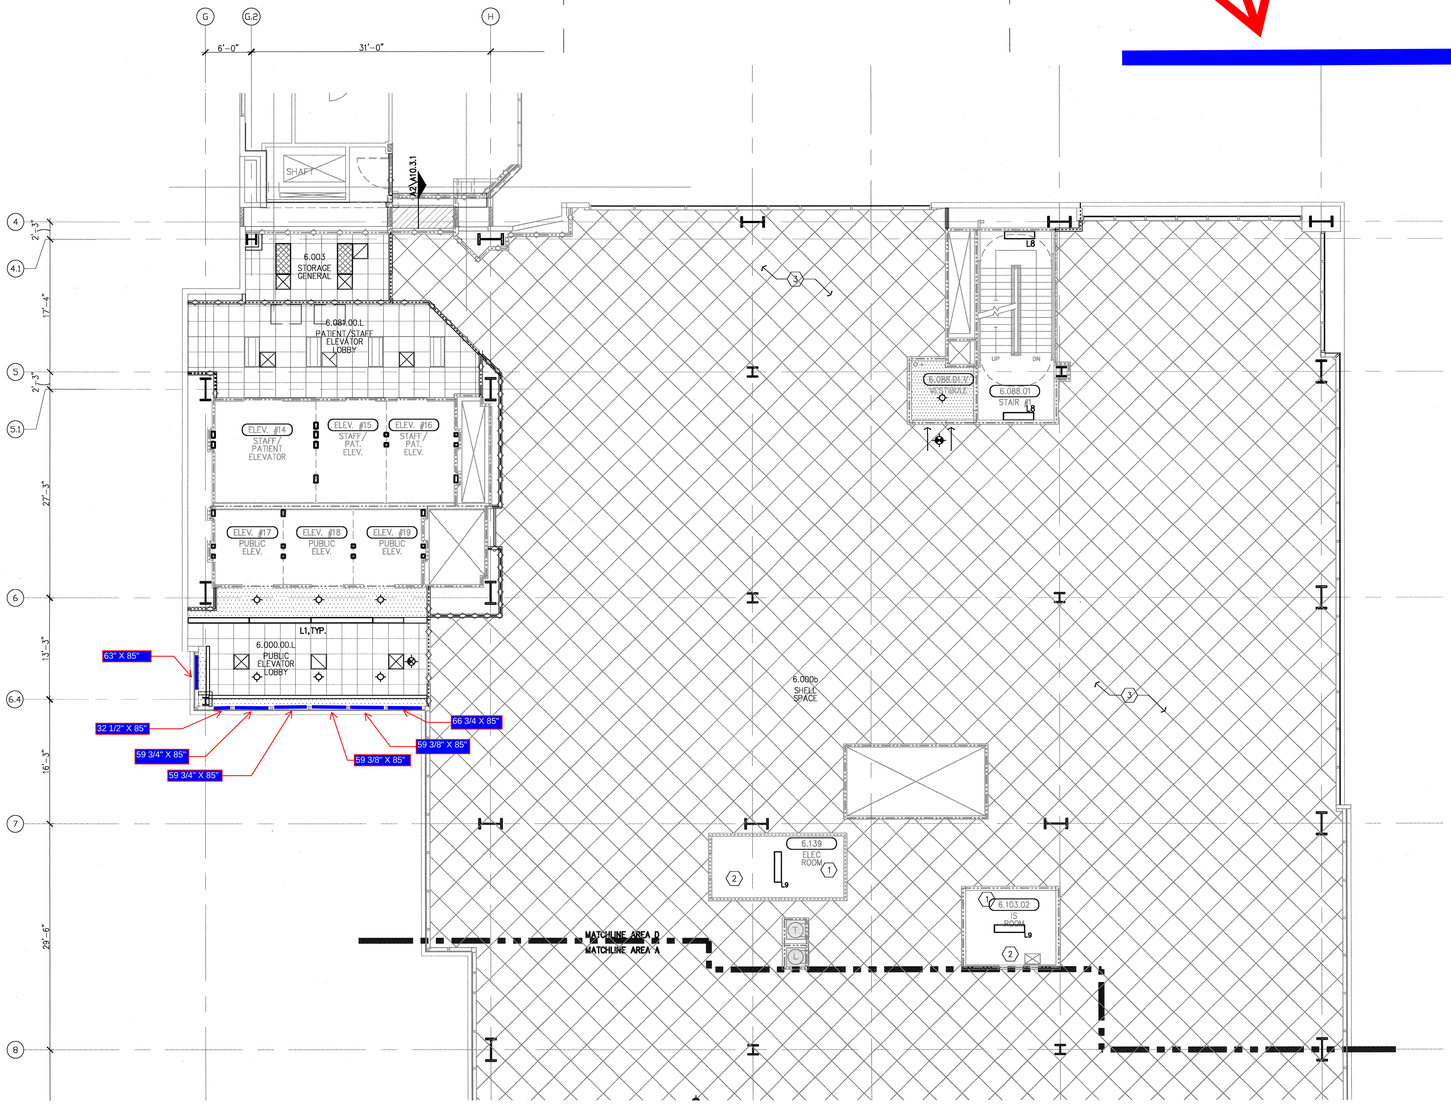

A6 AREA D
1/8" = 1'-0"

1. Wall mounted diffusers, see Mechanical drawings.
2. No ceiling, exposed to structure.
3. See Electrical and Mechanical for lighting and HVAC in this space.


A2 NOTES TO SHEET

- X-RAY – IN USE LIGHT
- LASER – IN USE LIGHT
- EXIT LIGHT FIXTURE
- RECESSED COMPACT FLUORESCENT DOWN LIGHT
- RECESSED COMPACT FLUORESCENT DIRECTIONAL SPOT LIGHT
- WALL MOUNTED LIGHT FIXTURE
- RECESSED COMPACT FLUORESCENT DOWN LIGHT WITH DIMMER
- RECESSED EXAM LIGHT, W/ WALL MOUNTED CONTROLS
- LOUIE LIGHTING, SD-888 RECESSED LIGHT
- R2 RECESSED FIXTURE, P-8900, PRUDENTIAL LIGHTING
- P1 LOUIS POULSEN, COLLAGE PENDANT
- P2 PENDANT FIXTURE, QUEENY DOWN II, BRUCK
- P3 BOYD, 9955 ARCHETYPE PENDANT, DIMMING SATIN NICKEL
- P4 BOYD, 10217 CATACAOS PENDANT (30"), DIMMING SATIN NICKEL
- P5 CORELITE, VERTECH 2T8 4' SUSPENDED DIRECT/INDIRECT LINEAR FIXTURE
- BOA CALO SWING SPOT, BRUCK, WITH V/A TRACK, BRUCK
- BRUCK LEDRA DISPLAY TRACK AND SPOT LIGHT
- COLOR KINETICS, iCOLOR FLEX SL, TRACK MOUNTING
- COLOR KINETICS, iCOLOR FLEX SL, STRING LIGHT
- INDIRECT COVE FIXTURE, P-59, PRUDENTIAL LIGHTING
- L1 PERIMETER WALL WASHER W/ ACRYLIC LENS ,FOCUS 1,FOCAL POINT
- L2 LED COVE LIGHT
- L3 FLUORESCENT COVE LIGHT
- L4 FLUORESCENT WITH FLUSH LENS, AVENUE b, FOCAL POINT
- L5 EUREKA C49169 LIGHT FIXTURE
- L6 CEILING MOUNTED NURSE CALL INDICATOR
- L7 4" X 2' FLUORESCENT WALL MOUNTED LIGHT FIXTURE
- RECESSED FLUORESCENT LIGHT FIXTURE
- L8 1' X 4' FLUORESCENT WALL MOUNTED LIGHT FIXTURE
- L9 1' X 4' FLUORESCENT UTILITY LIGHT FIXTURE
- L10 SURFACE MOUNTED LED LIGHT
- 2' X 4' FLUORESCENT LIGHT FIXTURE WITH PARABOLIC LENS
- 2' X 4' FLUORESCENT LIGHT FIXTURE DIRECT/INDIRECT
- 2' X 4' FLUORESCENT LIGHT FIXTURE WITH PRISMATIC LENS
- MULTI FUNCTION PATIENT LIGHT FIXTURE
- SQUARE MECHANICAL GRILLES
- LINEAR MECHANICAL GRILLES
- PLASTER CEILING
- METAL PANEL SOFFIT
- GYPSUM BOARD CEILING
- 2' X 2' SUSPENDED ACOUSTICAL TILE

C1 LEGEND
N.T.S

A. REFER TO "FINISH SCHEDULE" FOR FURTHER DEFINITION OF CEILING MATERIALS AND FINISHES.
B. CEILING HEIGHT WILL TYPICALLY BE [9'-0"], UNLESS OTHERWISE NOTED ON THE REFLECTED CEILING PLAN.
C. LOCATE ALL CEILING MOUNTED SMOKE DETECTORS AND SPEAKERS IN THE CENTER OF FULL PANELS AT LAY-IN CEILINGS.
D. LOCATE ALL SPRINKLER HEADS IN THE CENTER OF FULL PANELS AT LAY-IN CEILINGS. AT GYPSUM BOARD CEILINGS, SYMMETRICALLY SPACE HEADS AND CENTER ON LIGHT ROWS WHERE AREA LIMITATIONS PERMIT.
E. REFER TO MEP DOCUMENTS FOR LOCATIONS OF CEILING ACCESS PANELS. UNLESS NOTED OR DETAILED OTHERWISE ACCESS PANELS IN TOILETS AND BACK OF HOUSE SPACES WITH DRYWALL OR PLASTER CEILINGS ARE TO BE PAINTED METAL. PLASTER OR DRYWALL CEILINGS WITH ACCESS PANELS IN AUTOPSY AND BODY HOLDING AREAS ARE TO BE STAINLESS STEEL.
F. FOR SEISMIC BRACING AND ANCHORAGE REQUIREMENTS FOR SUSPENDED ACOUSTICAL CEILINGS, SEE SHEET A11.10.
G. FOR SEISMIC BRACING AND ANCHORAGE REQUIREMENTS FOR SUSPENDED GYPSUM BOARD CEILINGS SEE SHEET A11.10.1.
H. GYPSUM BOARD FURROWN HEADERS WILL NOT BE LOWER THAN 8' A.F.F.
I. ALL CEILING MOUNTED ITEMS WITH EQUIPMENT TAGS IDENTIFIED ON EQUIPMENT SERIES SHEETS ARE CROSSED REFERENCE TO STRUCTURAL SUPPORT DETAILS VIA MATRIX SHOWN ON EQUIPMENT DRAWINGS.
J. FOR ALL LAY IN CEILING PANELS ARRANGE CEILINGS TO NOT HAVE LESS THAN ½" CEILING TILE UNLESS OTHERWISE NOTED.
K. PROVIDE 2" WIDE TRIM AT ALL PERIMETER OF ACOUSTICAL CEILING GRID SYSTEM TO MEET SEISMIC REQUIREMENTS.
L. IN THE EVENT OF A CONFLICT BETWEEN REFLECTED CEILING PLANS AND FINISH SCHEDULES, THE REQUIREMENTS OF TABLE 1224.1 CBC 2007 PART 2 SHALL GOVERN.

B1 GENERAL NOTES
N.T.S

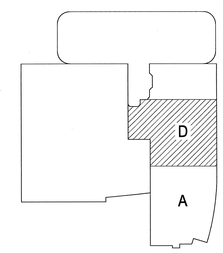

A1 KEY PLAN

FKP Architects

ARCHITECT OF RECORD
Paul C. Gloriod

LICENSED ARCHITECT
PAUL CHRISTOPHER GLORIOD
C-31500
4/30/2011
RENEWAL DATE
STATE OF CALIFORNIA
01/27/2010

REVISIONS

APPROVAL
REVIEWED IN ACCORDANCE WITH THE REQUIREMENTS OF T24, CCR
APPROVED
JAN 28 2010
Office of Statewide Health Planning & Development
FACILITIES DEVELOPMENT DIVISION

PROJECT NAME
CHILDREN'S HOSPITAL OF ORANGE COUNTY
455 S. Main St.
Orange, CA 92868-3874

TOWER II

CHOC SM HOSPITAL

PROJECT NUMBER
12011.00
Increment #7

OSHPD - PROJECT NUMBER
IL 072072-30

ISSUE
OSHPD PERMIT

DATE
01/27/2010

SCALE
1/8" = 1' - 0"


DRAWING TITLE
LEVEL 6
REFLECTED
CEILING PLAN
AREA - D

DRAWING NUMBER
A4.6D

C:\Projects\12000.00\CHOC\Sheets\Archive\D\A4.6D.dwg
1/25/2010
MEETA

© 2009 FKP Architects, Inc. All rights reserved. No part of this document may be reproduced or utilized in any form without prior written authorization of FKP Ar

Indicates Roller Shade size & location.

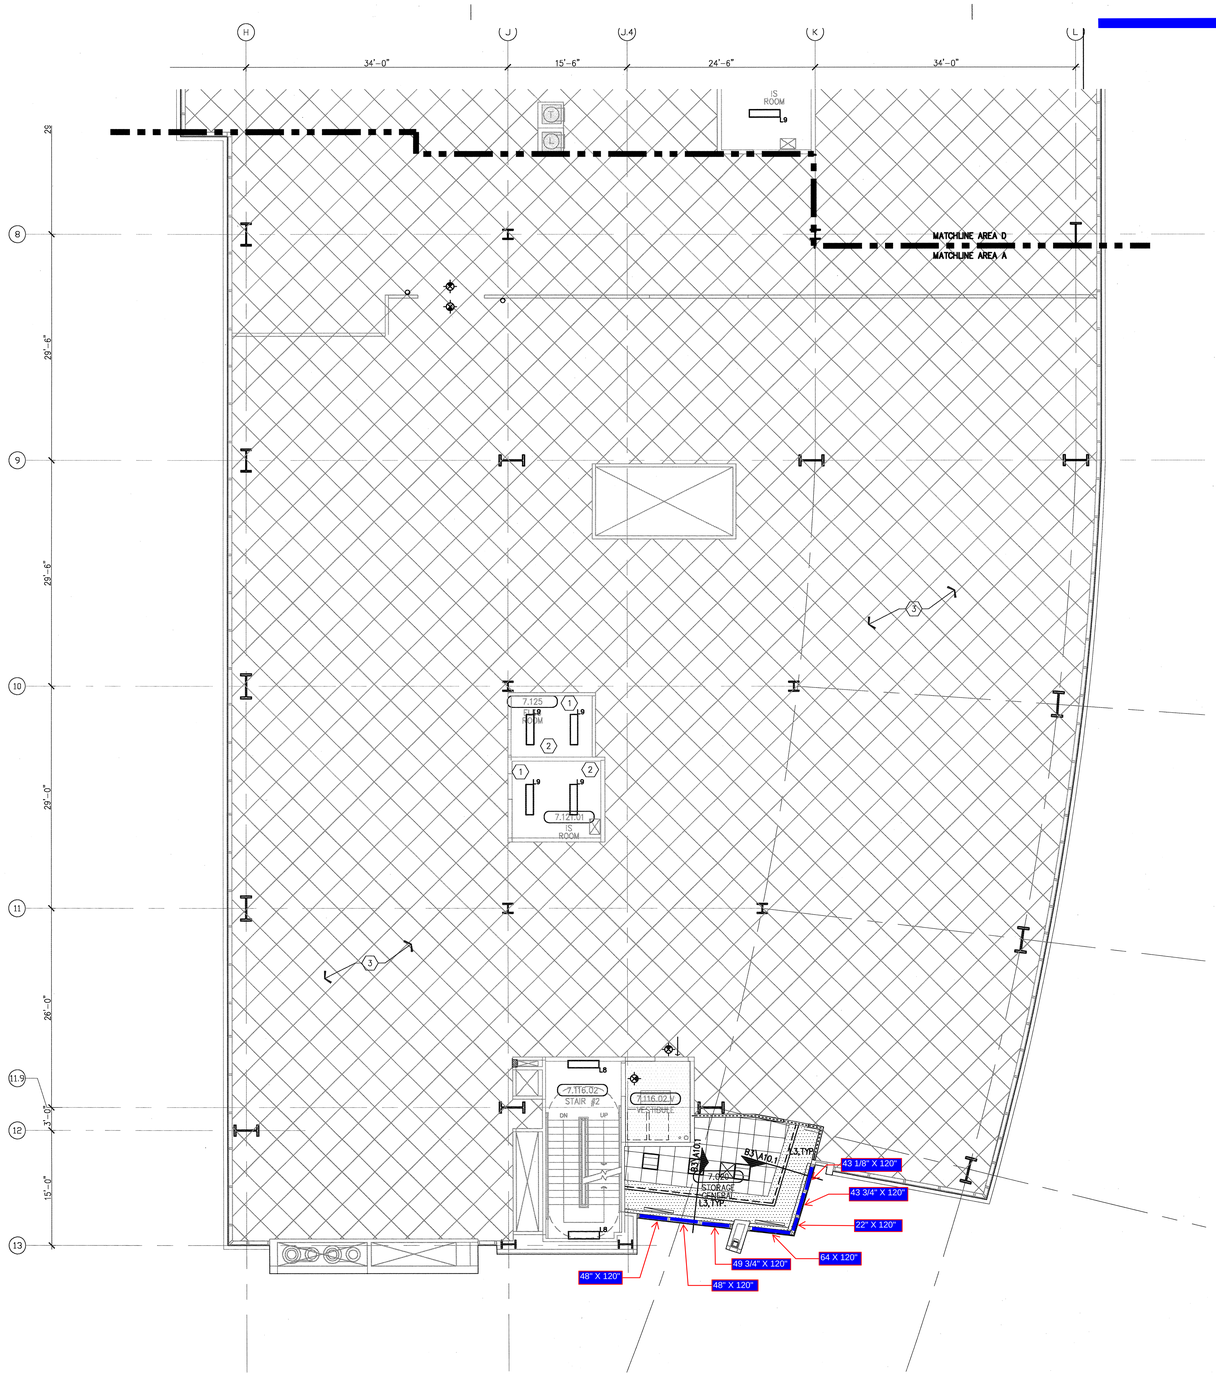

A6 AREA A
1/8" = 1'-0"

X-RAY – IN USE LIGHT
LASER – IN USE LIGHT
EXIT LIGHT FIXTURE
RECESSED COMPACT FLUORESCENT DOWN LIGHT
RECESSED COMPACT FLUORESCENT DIRECTIONAL SPOT LIGHT
WALL MOUNTED LIGHT FIXTURE
RECESSED COMPACT FLUORESCENT DOWN LIGHT WITH DIMMER
RECESSED EXAM LIGHT, W/ WALL MOUNTED CONTROLS
LOUIE LIGHTING, SD-888 RECESSED LIGHT
R2 RECESSED FIXTURE, P-8900, PRUDENTIAL LIGHTING
P1 LOUIS POULSEN, COLLAGE PENDANT
P2 PENDANT FIXTURE, QUEENY DOWN II, BRUCK
P3 BOYD, 9955 ARCHETYPE PENDANT, DIMMING SATIN NICKEL
P4 BOYD, 10217 CATACAOS PENDANT (30"), DIMMING SATIN NICKEL
P5 CORELITE, VERTECH 218 4' SUSPENDED DIRECT/INDIRECT LINEAR FIXTURE
BOA CALO SWNG SPOT, BRUCK, WITH V/A TRACK, BRUCK
BRUCK LEDRA DISPLAY TRACK AND SPOT LIGHT
COLOR KINETICS, iCOLOR FLEX SL, TRACK MOUNTING
COLOR KINETICS, iCOLOR FLEX SL, STRING LIGHT
L1 INDIRECT COVE FIXTURE, P-59, PRUDENTIAL LIGHTING
L2 PERIMETER WALL WASHER W/ ACRYLIC LENS ,FOCUS 1,FOCAL POINT
L3 LED COVE LIGHT
L4 FLUORESCENT COVE LIGHT
L5 FLUORESCENT WITH FLUSH LENS, AVENUE b, FOCAL POINT
L6 EUREKA C49169 LIGHT FIXTURE
CEILING MOUNTED NURSE CALL INDICATOR
L7 4" X 2' FLUORESCENT WALL MOUNTED LIGHT FIXTURE
RECESSED FLUORESCENT LIGHT FIXTURE
L8 1' X 4' FLUORESCENT WALL MOUNTED LIGHT FIXTURE
L9 1' X 4' FLUORESCENT UTILITY LIGHT FIXTURE
L10 SURFACE MOUNTED LED LIGHT
2' X 4' FLUORESCENT LIGHT FIXTURE WITH PARABOLIC LENS
2' X 4' FLUORESCENT LIGHT FIXTURE DIRECT/INDIRECT
2' X 4' FLUORESCENT LIGHT FIXTURE WITH PRISMATIC LENS
MULTI FUNCTION PATIENT LIGHT FIXTURE
SQUARE MECHANICAL GRILLES
LINEAR MECHANICAL GRILLES
PLASTER CEILING
METAL PANEL SOFFIT
GYPSUM BOARD CEILING
2' X 2' SUSPENDED ACOUSTICAL TILE


C1 LEGEND

A. REFER TO "FINISH SCHEDULE" FOR FURTHER DEFINITION OF CEILING MATERIALS AND FINISHES.
B. CEILING HEIGHT WILL TYPICALLY BE [9'-0"], UNLESS OTHERWISE NOTED ON THE REFLECTED CEILING PLAN.
C. LOCATE ALL CEILING MOUNTED SMOKE DETECTORS AND SPEAKERS IN THE CENTER OF FULL PANELS AT LAY-IN CEILINGS.
D. LOCATE ALL SPRINKLER HEADS IN THE CENTER OF FULL PANELS AT LAY-IN CEILINGS. AT GYPSUM BOARD CEILINGS, SYMMETRICALLY SPACE HEADS AND CENTER ON LIGHT ROWS WHERE AREA LIMITATIONS PERMIT.
E. REFER TO MEP DOCUMENTS FOR LOCATIONS OF CEILING ACCESS PANELS. UNLESS NOTED OR DETAILED OTHERWISE ACCESS PANELS IN TOILETS AND BACK OF HOUSE SPACES WITH DRYWALL OR PLASTER CEILINGS ARE TO BE PAINTED METAL. PLASTER OR DRYWALL CEILINGS WITH ACCESS PANELS IN AUTOPSY AND BODY HOLDING AREAS ARE TO BE STAINLESS STEEL.
F. FOR SEISMIC BRACING AND ANCHORAGE REQUIREMENTS FOR SUSPENDED ACOUSTICAL CEILINGS, SEE SHEET A11.10.
G. FOR SEISMIC BRACING AND ANCHORAGE REQUIREMENTS FOR SUSPENDED GYPSUM BOARD CEILINGS SEE SHEET A11.10.1.
H. GYPSUM BOARD FURRDOWN HEADERS WILL NOT BE LOWER THAN 8' A.F.F.
I. ALL CEILING MOUNTED ITEMS WITH EQUIPMENT TAGS IDENTIFIED ON EQUIPMENT SERIES SHEETS ARE CROSSED REFERENCE TO STRUCTURAL SUPPORT DETAILS VIA MATRIX SHOWN ON EQUIPMENT DRAWINGS.
J. FOR ALL LAY IN CEILING PANELS ARRANGE CEILINGS TO NOT HAVE LESS THAN ½" CEILING TILE UNLESS OTHERWISE NOTED.
K. PROVIDE 2" WIDE TRIM AT ALL PERIMETER OF ACOUSTICAL CEILING GRID SYSTEM TO MEET SEISMIC REQUIREMENTS.
L. IN THE EVENT OF A CONFLICT BETWEEN REFLECTED CEILING PLANS AND FINISH SCHEDULES, THE REQUIREMENTS OF TABLE 1224.1 CBC 2007 PART 2 SHALL GOVERN.

B1 GENERAL NOTES

1. Wall mounted diffusers, see Mechanical drawings.
2. No ceiling, exposed to structure.
3. See Electrical and Mechanical for lighting and HVAC in this space.

A2 NOTES TO SHEET

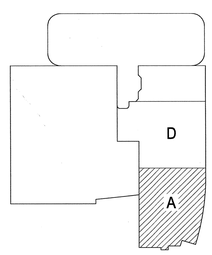

A1 KEY PLAN

FKP Architects

ARCHITECT OF RECORD
Paul C. Gloriod

LICENSED ARCHITECT
PAUL CHRISTOPHER GLORIOD
C-31500
4/30/2011
RENEWAL DATE
STATE OF CALIFORNIA
01/27/2010

REVISIONS

APPROVAL
REVIEWED IN ACCORDANCE WITH THE REQUIREMENTS OF T24, CCR
APPROVED
JAN 28 2010
Office of Statewide Health Planning & Development
FACILITIES DEVELOPMENT DIVISION

PROJECT NAME
CHILDREN'S HOSPITAL OF ORANGE COUNTY
455 S. Main St.
Orange, CA 92868-3874

TOWER II

CHOC SM HOSPITAL

PROJECT NUMBER
12011.00
Increment #7

OSHPD - PROJECT NUMBER
IL 072072-30

ISSUE
OSHPD PERMIT

DATE
01/27/2010


SCALE
1/8"=1'-0"

DRAWING TITLE
LEVEL 7 REFLECTED CEILING PLAN AREA - A

DRAWING NUMBER
A4.7A

G:\P\CHOC\12002-00\CHOC\SHEETS\ACTIVE\00 CVR.DWG
1/25/2010
AMEITA

© 2009 FKP Architects, Inc. All rights reserved. No part of this document may be reproduced or utilized in any form without prior written authorization of FKP Architects, Inc.

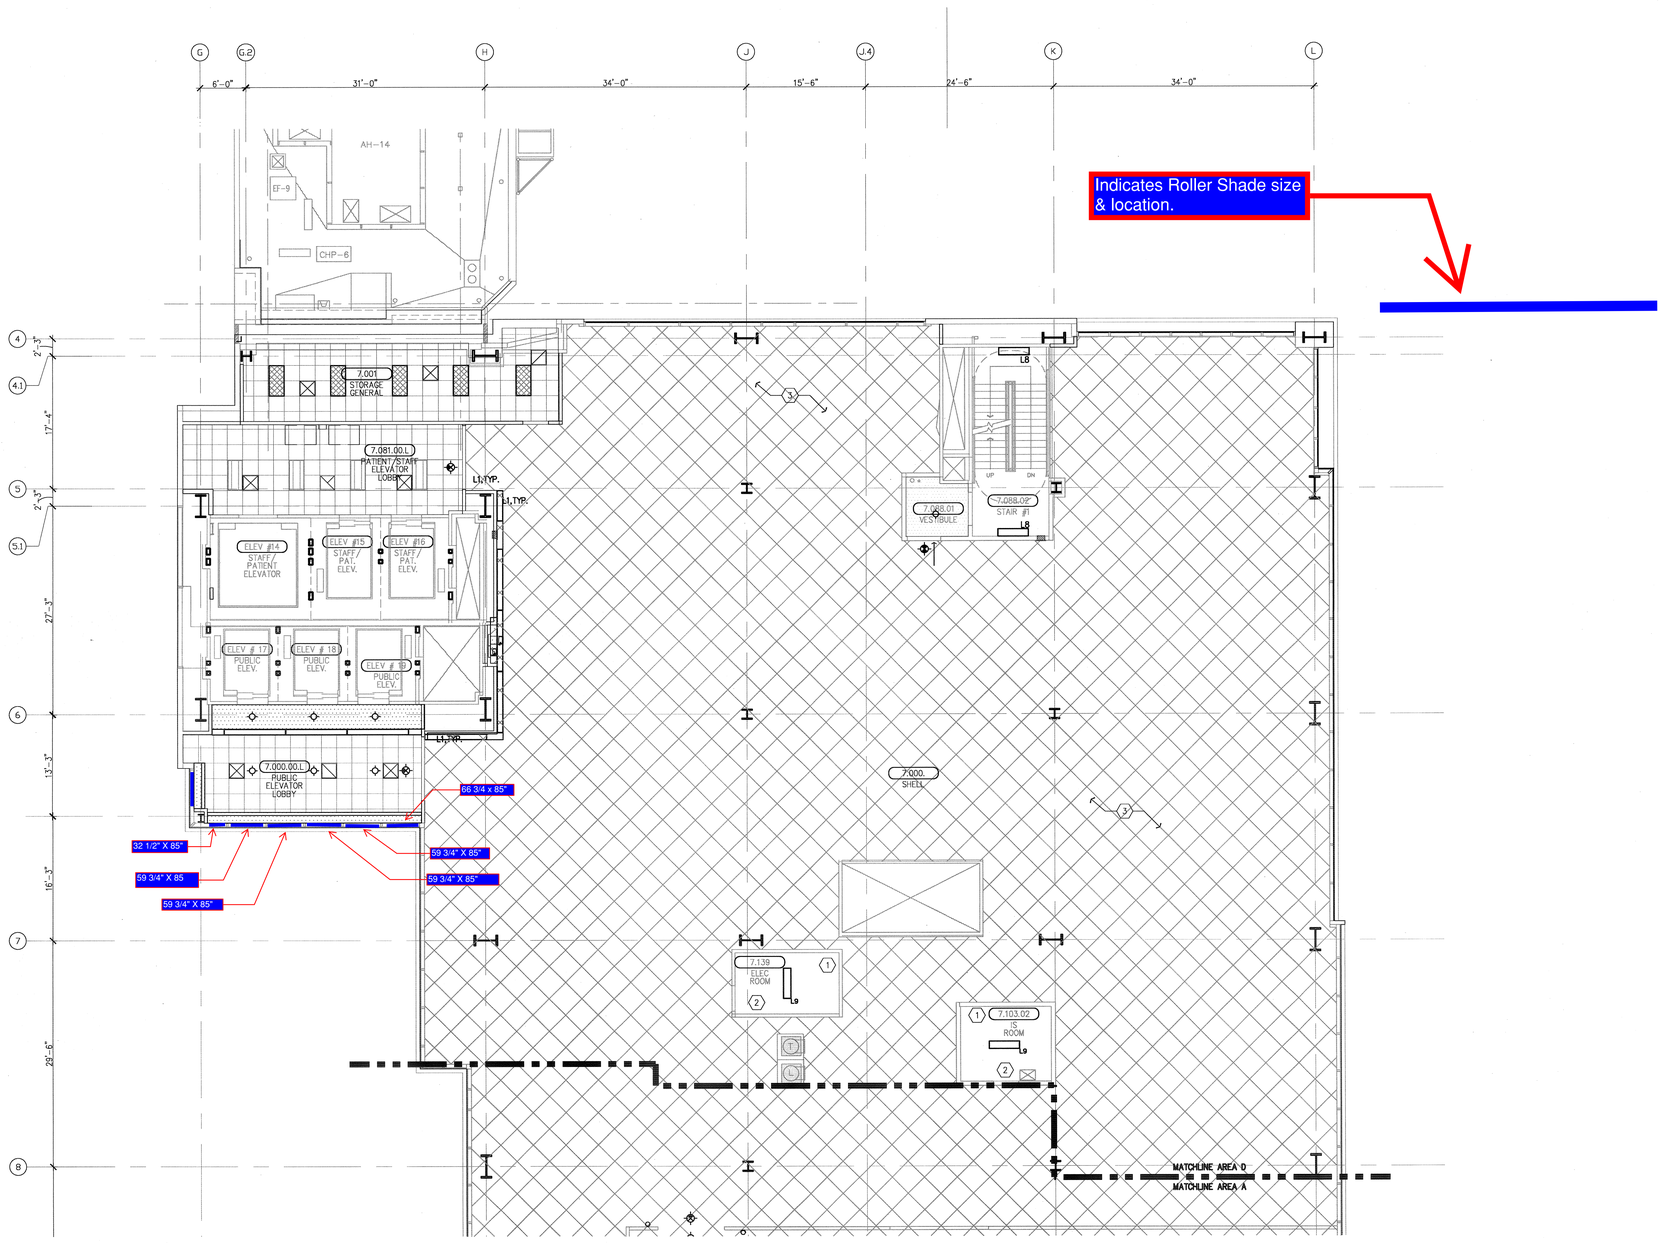

B6 AREA D
1/8"=1'-0"

1. Wall mounted diffusers, see Mechanical drawings.
2. No ceiling, exposed to structure.
3. See Electrical and Mechanical for lighting and HVAC in this space.


A2 NOTES TO SHEET

- X-RAY – IN USE LIGHT
- LASER – IN USE LIGHT
- EXIT LIGHT FIXTURE
- RECESSED COMPACT FLUORESCENT DOWN LIGHT
- RECESSED COMPACT FLUORESCENT DIRECTIONAL SPOT LIGHT
- WALL MOUNTED LIGHT FIXTURE
- D RECESSED COMPACT FLUORESCENT DOWN LIGHT WITH DIMMER
- RECESSED EXAM LIGHT, W/ WALL MOUNTED CONTROLS
- LOUIE LIGHTING, SD-888 RECESSED LIGHT
- R2 RECESSED FIXTURE, P-8900, PRUDENTIAL LIGHTING
- P1 LOUIS POULSEN, COLLAGE PENDANT
- P2 PENDANT FIXTURE, QUEENY DOWN II, BRUCK
- P3 BOYD, 9955 ARCHETYPE PENDANT, DIMMING SATIN NICKEL
- P4 BOYD, 10217 CATACAOS PENDANT (30"), DIMMING SATIN NICKEL
- P5 CORELITE, VERTECH 218 4' SUSPENDED DIRECT/INDIRECT LINEAR FIXTURE
- BOA CALO SWING SPOT, BRUCK, WITH V/A TRACK, BRUCK
- BRUCK LEDRA DISPLAY TRACK AND SPOT LIGHT
- COLOR KINETICS, ICOLOR FLEX SL, TRACK MOUNTING
- COLOR KINETICS, ICOLOR FLEX SL, STRING LIGHT
- L1 INDIRECT COVE FIXTURE, P-59, PRUDENTIAL LIGHTING
- L2 PERIMETER WALL WASHER W/ ACRYLIC LENS ,FOCUS 1,FOCAL POINT
- L3 LED COVE LIGHT
- L4 FLUORESCENT COVE LIGHT
- L5 FLUORESCENT WITH FLUSH LENS, AVENUE b, FOCAL POINT
- L6 EUREKA C49169 LIGHT FIXTURE
- CEILING MOUNTED NURSE CALL INDICATOR
- L7 4" X 2' FLUORESCENT WALL MOUNTED LIGHT FIXTURE
- RECESSED FLUORESCENT LIGHT FIXTURE
- L8 1' X 4' FLUORESCENT WALL MOUNTED LIGHT FIXTURE
- L9 1' X 4' FLUORESCENT UTILITY LIGHT FIXTURE
- L10 SURFACE MOUNTED LED LIGHT
- 2' X 4' FLUORESCENT LIGHT FIXTURE WITH PARABOLIC LENS
- 2' X 4' FLUORESCENT LIGHT FIXTURE DIRECT/INDIRECT
- 2' X 4' FLUORESCENT LIGHT FIXTURE WITH PRISMATIC LENS
- MULTI FUNCTION PATIENT LIGHT FIXTURE
- SQUARE MECHANICAL GRILLES
- LINEAR MECHANICAL GRILLES
- PLASTER CEILING
- METAL PANEL SOFFIT
- GYPSUM BOARD CEILING
- 2' X 2' SUSPENDED ACOUSTICAL TILE

C1 LEGEND

A. REFER TO "FINISH SCHEDULE" FOR FURTHER DEFINITION OF CEILING MATERIALS AND FINISHES.
B. CEILING HEIGHT WILL TYPICALLY BE [9'-0"], UNLESS OTHERWISE NOTED ON THE REFLECTED CEILING PLAN.
C. LOCATE ALL CEILING MOUNTED SMOKE DETECTORS AND SPEAKERS IN THE CENTER OF FULL PANELS AT LAY-IN CEILINGS.
D. LOCATE ALL SPRINKLER HEADS IN THE CENTER OF FULL PANELS AT LAY-IN CEILINGS. AT GYPSUM BOARD CEILINGS, SYMMETRICALLY SPACE HEADS AND CENTER ON LIGHT ROWS WHERE AREA LIMITATIONS PERMIT.
E. REFER TO MEP DOCUMENTS FOR LOCATIONS OF CEILING ACCESS PANELS. UNLESS NOTED OR DETAILED OTHERWISE ACCESS PANELS IN TOILETS AND BACK OF HOUSE SPACES WITH DRYWALL OR PLASTER CEILINGS ARE TO BE PAINTED METAL. PLASTER OR DRYWALL CEILINGS WITH ACCESS PANELS IN AUTOPSY AND BODY HOLDING AREAS ARE TO BE STAINLESS STEEL.
F. FOR SEISMIC BRACING AND ANCHORAGE REQUIREMENTS FOR SUSPENDED ACOUSTICAL CEILINGS, SEE SHEET A11.10.
G. FOR SEISMIC BRACING AND ANCHORAGE REQUIREMENTS FOR SUSPENDED GYPSUM BOARD CEILINGS SEE SHEET A11.10.1.
H. GYPSUM BOARD FURRDOWN HEADERS WILL NOT BE LOWER THAN 8' A.F.F.
I. ALL CEILING MOUNTED ITEMS WITH EQUIPMENT TAGS IDENTIFIED ON EQUIPMENT SERIES SHEETS ARE CROSSED REFERENCE TO STRUCTURAL SUPPORT DETAILS VIA MATRIX SHOWN ON EQUIPMENT DRAWINGS.
J. FOR ALL LAY IN CEILING PANELS ARRANGE CEILINGS TO NOT HAVE LESS THAN ½" CEILING TILE UNLESS OTHERWISE NOTED.
K. PROVIDE 2" WIDE TRIM AT ALL PERIMETER OF ACOUSTICAL CEILING GRID SYSTEM TO MEET SEISMIC REQUIREMENTS.
L. IN THE EVENT OF A CONFLICT BETWEEN REFLECTED CEILING PLANS AND FINISH SCHEDULES, THE REQUIREMENTS OF TABLE 1224.1 CBC 2007 PART 2 SHALL GOVERN.

B1 GENERAL NOTES

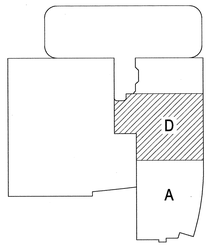

A1 KEY PLAN

FKP Architects

ARCHITECT OF RECORD
Paul C. Gloriod

LICENSED ARCHITECT
PAUL CHRISTOPHER GLORIOD
C-31500
4/30/2011
RENEWAL DATE
STATE OF CALIFORNIA
01/27/2010

REVISIONS

APPROVAL

REVIEWED IN ACCORDANCE WITH THE REQUIREMENTS OF T24, CCR
APPROVED
JAN 28 2010
Office of Statewide Health Planning & Development
FACILITIES DEVELOPMENT DIVISION

PROJECT NAME
CHILDREN'S HOSPITAL OF ORANGE COUNTY
455 S. Main St.
Orange, CA 92868-3874

TOWER II

CHOC SM HOSPITAL

PROJECT NUMBER
12011.00
Increment #7

OSHPD - PROJECT NUMBER
IL 072072-30

ISSUE
OSHPD PERMIT

DATE
01/27/2010

SCALE
1/8"=1'-0"

DRAWING TITLE
LEVEL 7 REFLECTED CEILING PLAN AREA - D

DRAWING NUMBER
A4.7D

G:\FA\CHOC\12002-00\CHOC\SHEETS\ACTIVE\DB\VA4.7D.DWG
1/25/2010
AMEHTA